

ADDENDUM #01

ADA Compliance Upgrades Foussat and Libby

BID NO. 2025-21-070B

The following changes, additions, deletions, clarifications, or corrections shall become part of the Request for Proposals for the above listed project. This Addendum #01 forms a part of the RFQ document and modifies the original documents. **Addendum #01 MUST Be acknowledged in the cover letter.** Failure to do so may subject response to disqualification.

Oceanside Unified School District	Program Management: CCM/MAAS
Bid No. 2025-21-070B ADA Compliance Upgrades – Foussat & Libby	Program Manager: Jim O'Reily

In	Informational Updates				
1.	RFI Responses				
2.	Jobwalk Sign in Sheet				
3.	Updates to General Conditions				
4.	Update to Sample Contract Conditions				

Question	Response
RFI #1:	Please see attachment A markups for clarification.
DWG Review	
- ADA Scope	
RFI #2: Pre-	Civil Engineer Latitude 33 clarifications on attachment B.
bid Scope	
Clarifications	
Jobwalk Sign	Attachment C.
in Sheet	
General	In determining the cost to the District and the extent of increase to
Conditions	the Contract Price resulting from a Change adding to the Work, the
9.5.2.3.1.	allowance for mark-ups on the costs of the Change for all overhead
Mark-up on	(including home office and field overhead), general conditions costs
Costs of	and profit associated with the Change shall not exceed fifteen percent
Changes to	(15%), regardless of the number of Subcontractors, of any tier,
the Work.	performing any portion of any Change to the Work. If a Change to the
	Work reduces the Contract Price, no profit, general conditions or
	overhead costs shall be paid by the District to the Contractor for the
	reduced or deleted Work. In such event, the adjustment to the
	Contract Price shall be the actual cost reduction realized by the
	reduced or deleted Work multiplied by the percentage set forth in the
	Special Conditions for mark-ups on the cost of a Change adding to the
	scope of the Work. Upon the approval of the District Representative,
	the usage of any allowance specified in this contract shall include a
	mark-up of no more than fifteen percent (15%). In the event that any



ADDENDUM #01

ADA Compliance Upgrades Foussat and Libby

BID NO. 2025-21-070B

	portion of the allowance is not utilized, the unspent amount shall be returned to the School District.
Sample Contract Conditions 8. <u>Mark-Up</u> <u>On Direct</u> <u>Costs of</u> <u>Changes</u>	In the event of Changes to the Work, pursuant to Article 9 of the General Conditions, the markup for all overhead, including but not limited to home-office overhead, safety, mailing or clean-up, field office overhead, all other general conditions costs, bond premium, and profit ("Change Order Mark-Up") for Changes completed by the Contractor shall be Fifteen percent (15%) of the direct actual costs for performance of the Change as determined in accordance with the provisions of Article 9 of the Construction General Conditions. For the portion of a Change completed by a Subcontractor, the Subcontractor Change Order Mark-Up shall be ten percent (10%) of the Subcontractor's direct actual costs and the Contractor may mark-up of five percent (5%) to the Subcontractor's direct actual costs for the Contractor's management, supervision and coordination of the Subcontractor's completion of such Change.

END OF ADDENDUM #01




Oceanside USD 2111 Mission Ave Oceanside, California 92054 P: (760) 966-4421

Attachment A

RFI #1: DWG Review - ADA Scope

Status	Closed on 04/16/25		
То	Amanda Weinstein (obrARCHITECTURE) (Response Required)	From	James McGrane (MAAS) California
Date Initiated	Apr 9, 2025	Due Date	Apr 16, 2025
Location		Project Stage	Bid
Cost Impact		Schedule Impact	
Spec Section			
Drawing Number	T1.3R, A-1.1R, A-1.3R	Reference	
Linked Drawings	<u>C1.0, C1.7, A-1.3R, C1.1, A-1.1R, C1.6, A-1.0R, A-1.4R, C1.2, A-2.0R, C1.8, T1.3R, C1.5</u>		
Received From	James McGrane (MAAS)		
Copies To	Nasser Behroozian (TYR, Inc), Corrisa Bolls (MAAS , Anney Rosenthal-Hall (obrARCHITECTURE), Amanda Weinstein (obrARCHITECTURE))	
Revision			
Activity			
Question	Drinking Fountain (Details)	ies found in the DSA a es not appear on Enlar _ SITE PLAN for Drinki ne understanding of wo	pproved set: ged Site Plan ng Fountain rather than A-1.3R for Kindergarten ork yet to be performed. <i>(Summary of Work narrative</i>
Official Response	Response from Amanda Weinstein obrARCHITI Please see attached markups for clarification. Attachments	ECTURE on Tuesday, /	Apr 15, 2025 at 04:42 PM PDT

2025_0410_RFI001-DWG Review - ADA Scope_obrRESPONSE.pdf

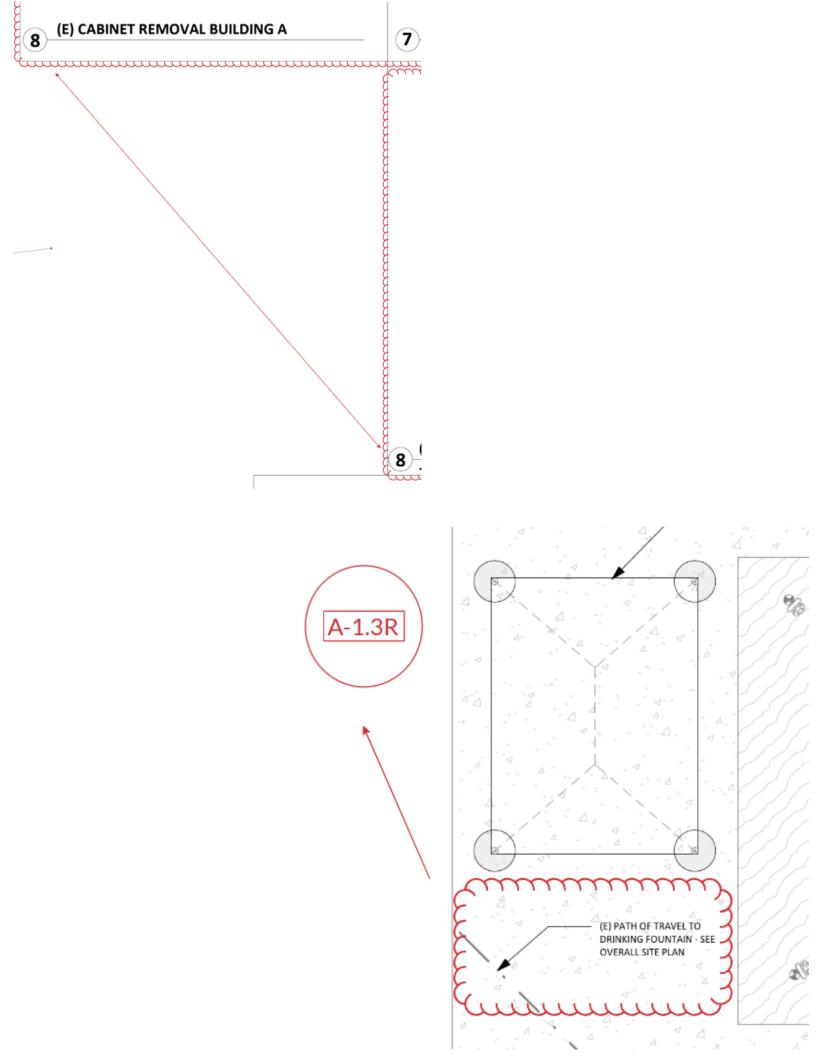

<u>Foussat</u>

A-1.0R OVERALL SITE PLAN

- (N) PEDESTRIAN GATE AT (N) POT
 - SEE DETAIL 4/T1.3R
- (E) TOW AWAY SIGNS NEED TO BE REPLACED
 - SEE DETAIL 7/T1.3R
- A-1.1R ENLARGED SITE PLAN KINDERGARTEN AREA
 - NEW CONCRETE SIDEWALK TO MEET ACCESSIBLE CLEARANCE PER DETAIL
 9/A-2.0R
 - 1.20 (N) PEDESTRIAN GATE WITH PANIC HARDWARE PER DETAIL 1/A-2.0R
- A-1.3R KINDERGARTEN DRINKING FOUNTAIN
 - ALL DETAILS (1-8)
- A-1.4R BUILDING A PATH OF TRAVEL/ DOOR CLEARANCES
 - ENTIRE SHEET
 - DEMO CASEWORK TO MEET 1'-0" LATCH SIDE REQUIRED CLEARANCE AT DOOR. VERIFY IN FIELD (3) CABINET DOORS TO BE REMOVED TO MEET 48" MIN APPROACH CLEARANCE; SAWCUT EXISTING CARCASS & REFINISH TO MATCH ADJACENT CASEWORK. SALVAGE EXISTING DOOR FOR REUSE @ NEW FACE OF CASEWORK. COUNTER TO REMAIN PROUD OF CABINETS BELOW TO MATCH ADJACENT OFFSET, WHILE STILL MEETING LATCH SIDE CLEARANCE
 - ADD NEW END PANEL TO MATCH EXISTING CASEWORK
 - REF. LINE INDICATING NEW FACE OF CASEWORK
- A-2.0R DETAILS
 - DETAIL 7 (E) BLDG B ENLARGED STAFF RESTROOM PLAN
 - DETAIL 8 RESTROOM MOUNTING HEIGHTS
- C1.0 OVERALL SITE PLAN
 - NEW CONSTRUCTION TO INCLUDE PAVING OF ADA ACCESS AISLES AND STALLS, INSTALLATION OF TRUNCATED DOMES, AND ACCESSIBLE LOADING/DROP OFF ZONES, NEW RAMPS AND ASSOCIATED PAVING
- C1.1 DEMOLITION PLAN
 - ENTIRE SHEET
- C1.2 FOUSSAT RELOS UPDATED PRECISE GRADING
 - ENTIRE SHEET
- C1.5 ADA DETAILS
 - ALL DETAILS (1-9)
- C1.6 ADA DETAILS
 - ALL DETAILS (1-5)
- C1.7 FOUSSAT LOT EROSION CONTROL NOTES DETAILS
 - ENTIRE SHEET
- C1.8 RELOS EROSION CONTROL PLAN
 - AREA OF WORK 3
 - ALL SCOPE
 - AREA OF WORK 1-2
 - AS APPROPRIATE BASED ON VERIFICATION OF EXISTING SITE CONDITIONS
- T-1.2R ACCESSIBILITY NOTES
 - DETAIL 1
 - AS APPROPRIATE BASED ON VERIFICATION OF EXISTING SITE CONDITIONS
- T-1.3R ACCESSIBILITY DETAILS
 - DETAIL 5 ACCESSIBLE PARKING SIGNAGE

- DETAIL 6 DRINKING FOUNTAIN CLEARANCES
 - AS APPROPRIATE BASED ON VERIFICATION OF EXISTING SITE CONDITIONS
- DETAIL 7 ACCESS PARKING TOW AWAY SIGN
- DETAIL 8 (E) DRINKING FOUNTAIN BUILDING 'E' ACCESSIBLE COMPLIANCE PER DETAIL 6/T1.3R
 - AS APPROPRIATE BASED ON VERIFICATION OF EXISTING SITE CONDITIONS
- DETAIL 8* (E) CABINET REMOVAL BUILDING A
 - REMOVAL OF CABINET TO MEET 12" CLEARANCE FOR ACCESSIBLE DOOR
 - REFERENCE DOOR CLEARANCE ON SHEET A-1.4R DOOR 3



Oceanside USD 2111 Mission Ave Oceanside, California 92054 P: (760) 966-4421

RFI #1: DWG Review - ADA Scope


Status	Open		
То	Amanda Weinstein (obrARCHITECTURE) (Response Required)	From	James McGrane (MAAS) California
Date Initiated	Apr 9, 2025	Due Date	Apr 16, 2025
Location		Project Stage	Bid
Cost Impact		Schedule Impact	
Spec Section			
Drawing Number	T1.3R, A-1.1R, A-1.3R	Reference	
Linked Drawings	C1.0, C1.7, A-1.3R, C1.1, A-1.1R, C1.6, A-1.0R, A- 1.4R, C1.2, A-2.0R, C1.8, T1.3R, C1.5		
Received From	James McGrane (MAAS)		
Copies To	Nasser Behroozian (TYR, Inc), Corrisa Bolls (MAAS) , Anney Rosenthal-Hall (obrARCHITECTURE), Amanda Weinstein (obrARCHITECTURE)		
Revision			
Activity			

Question Question from James McGrane MAAS on Monday, Apr 7, 2025 at 11:15 AM PDT Please provide clarity on the following inconsistencies found in the DSA approved set: • T1.3R - Two detail #8's • A-1.1R - Kindergarten Drinking Fountain does not appear on Enlarged Site Plan · Callout on POT references OVERALL SITE PLAN for Drinking Fountain rather than A-1.3R for Kindergarten Drinking Fountain (Details) Please confirm that the clouded sheets align with the understanding of work yet to be performed. (Summary of Work narrative attached for reference.) Attachments Screenshot 2025-04-07 114612.png, Screenshot 2025-04-07 115303.png, 01-01-00_Summary_Foussat-ADA.pdf Awaiting an Official Response


Please see the attached sheets for markups clarifying inconsistencies. The two detail #8s on T-1.3R have been renamed to 8A and 8B.


A note has been added to clarify that the drinking fountain details on A-1.3R apply to the kindergarten drinking fountain, called out on the overall site plan.


Please note that in review, the reference for A-1.0R to see Detail 4/T-1.3R was noted to be incorrect. This should reference detail 3/T-1.3R as noted on A-1.0R, and should be revised on the first bullet point of the summary.

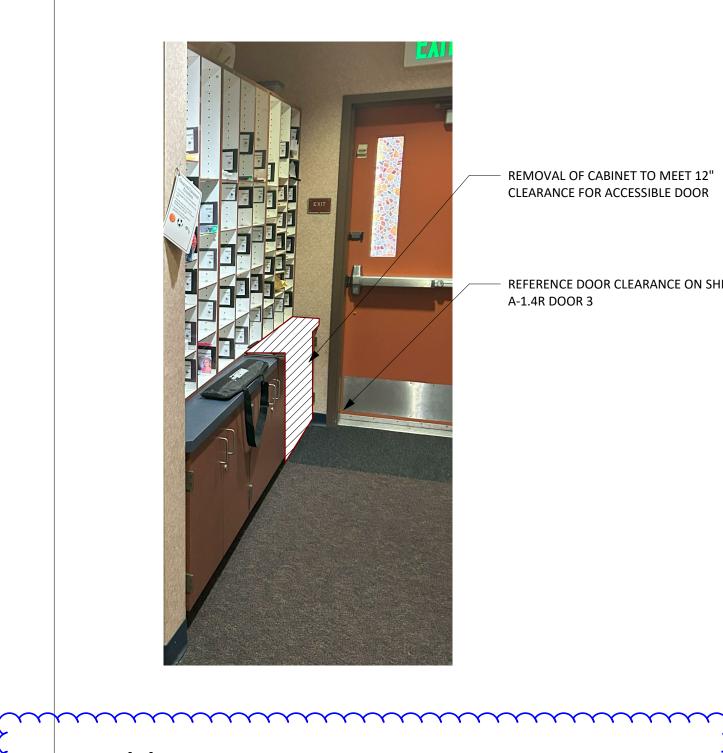

(E) CABINET REMOVAL BUILDING A

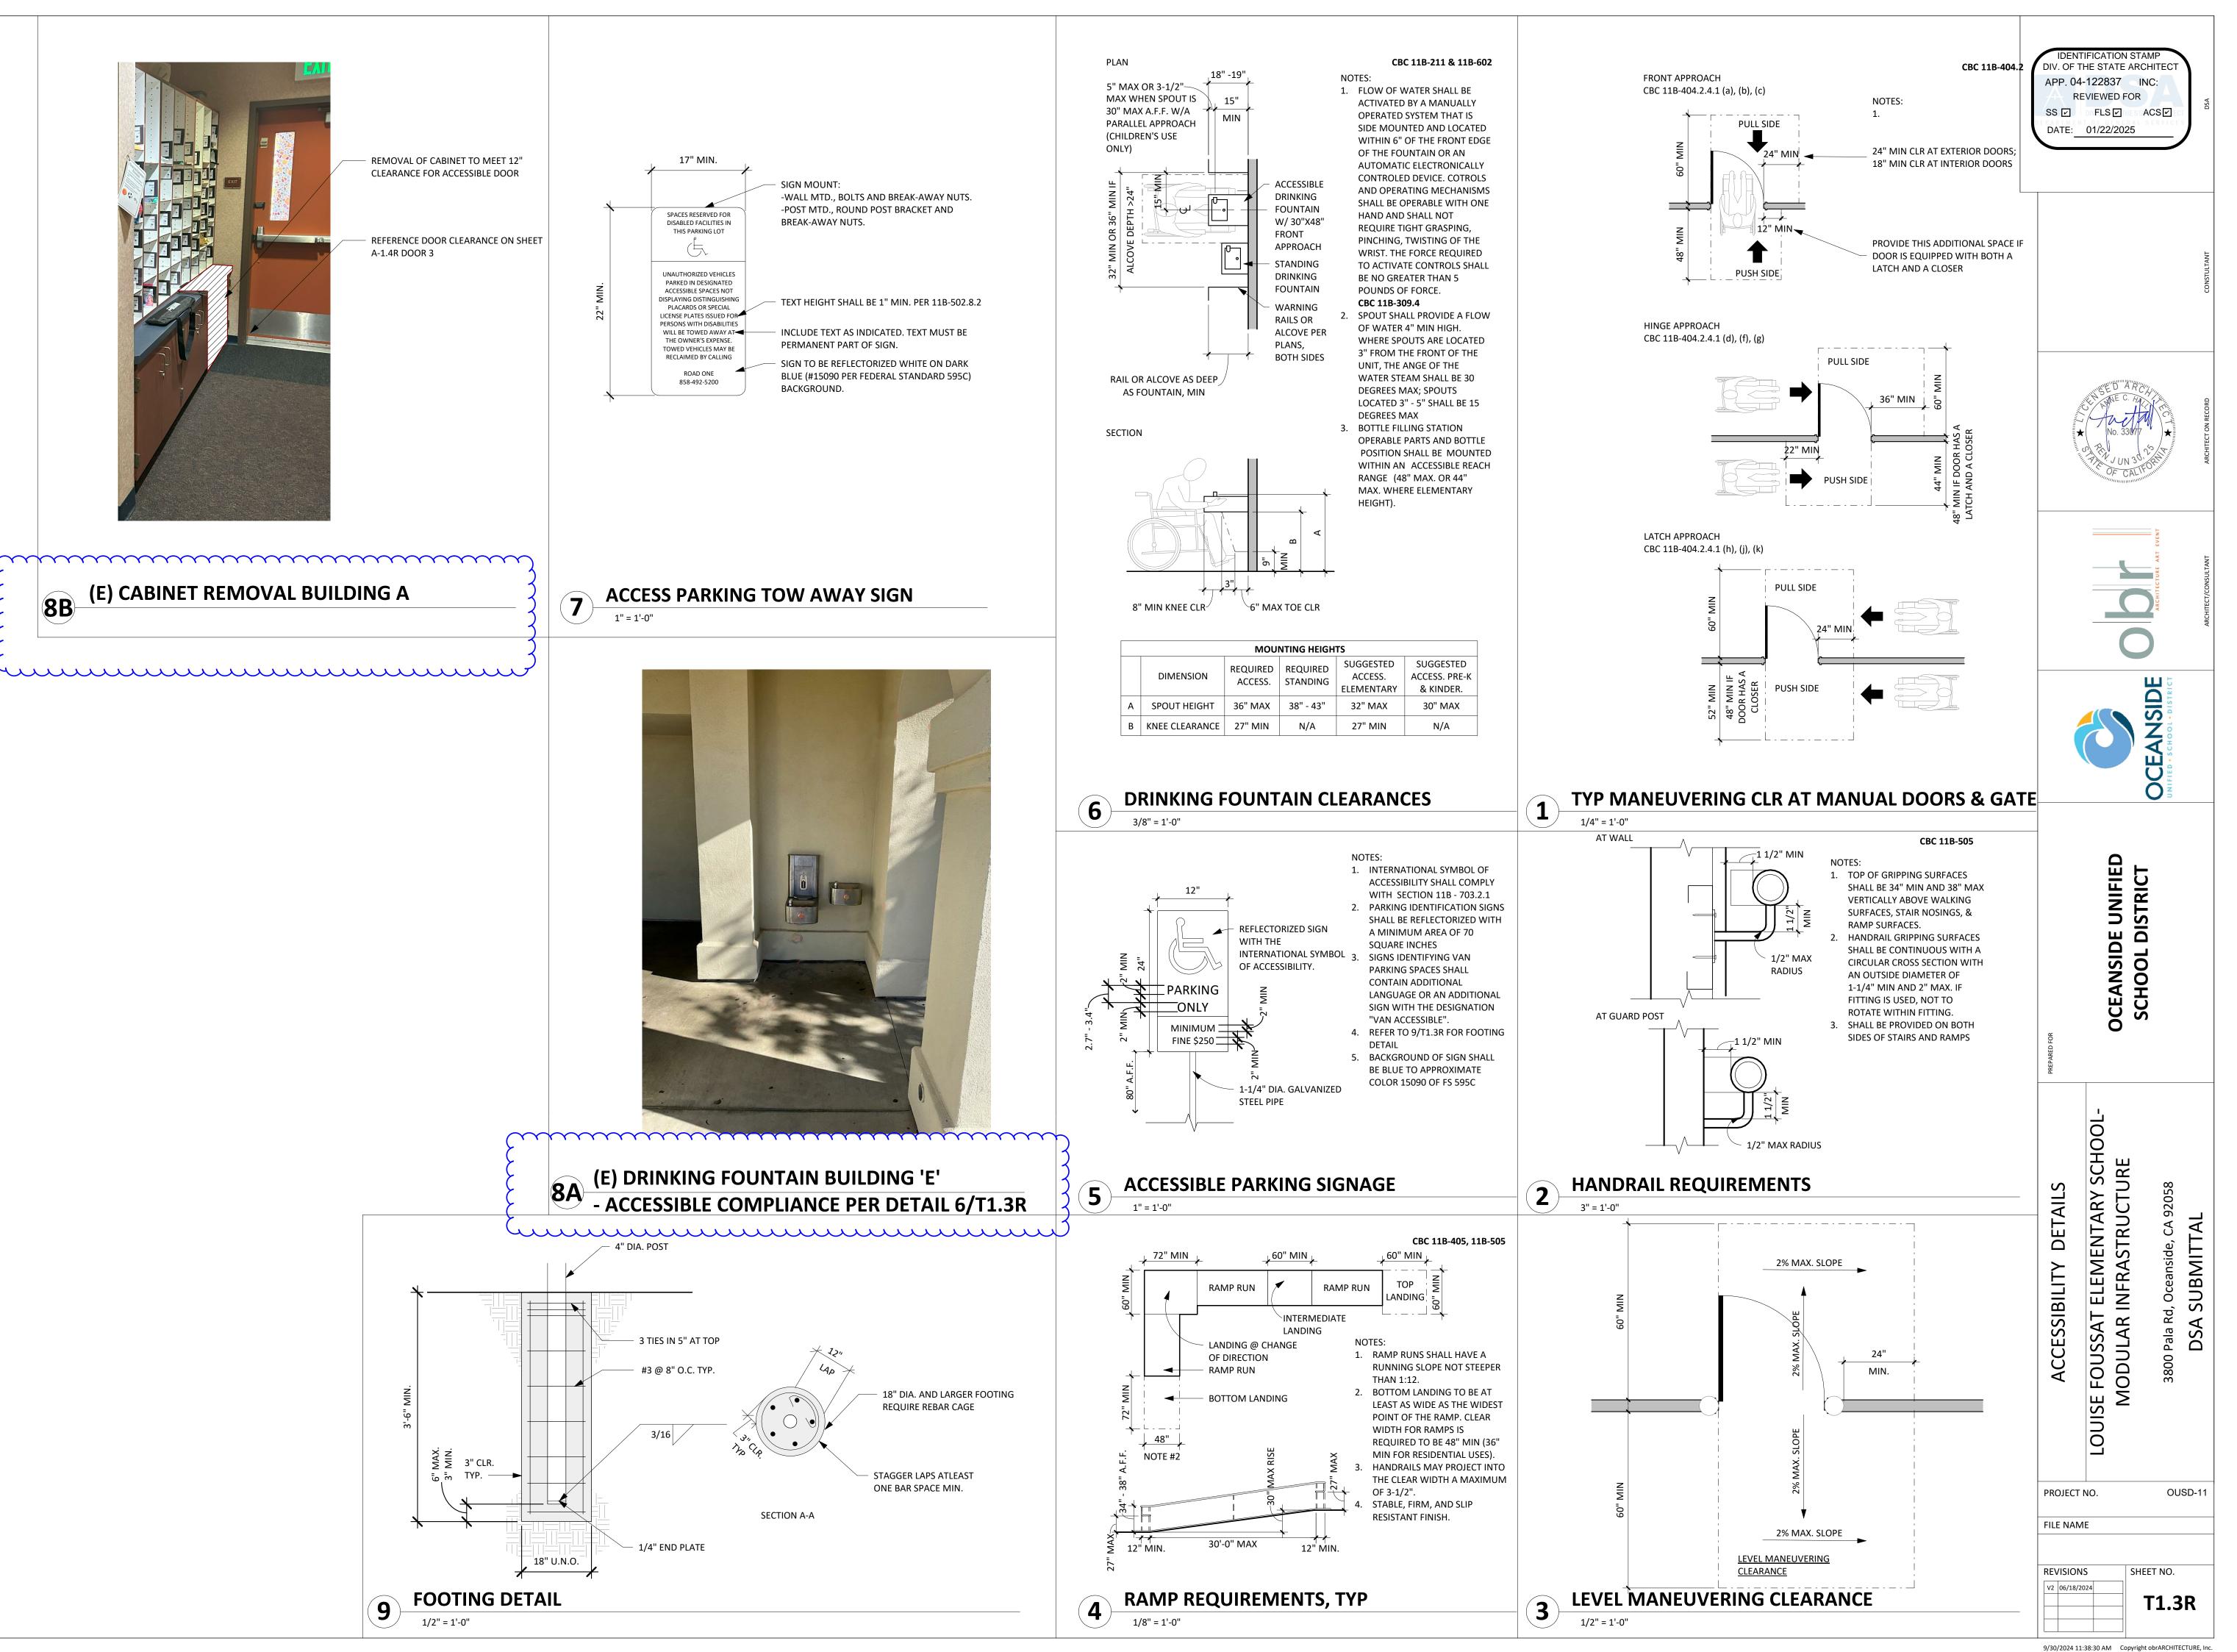


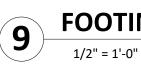

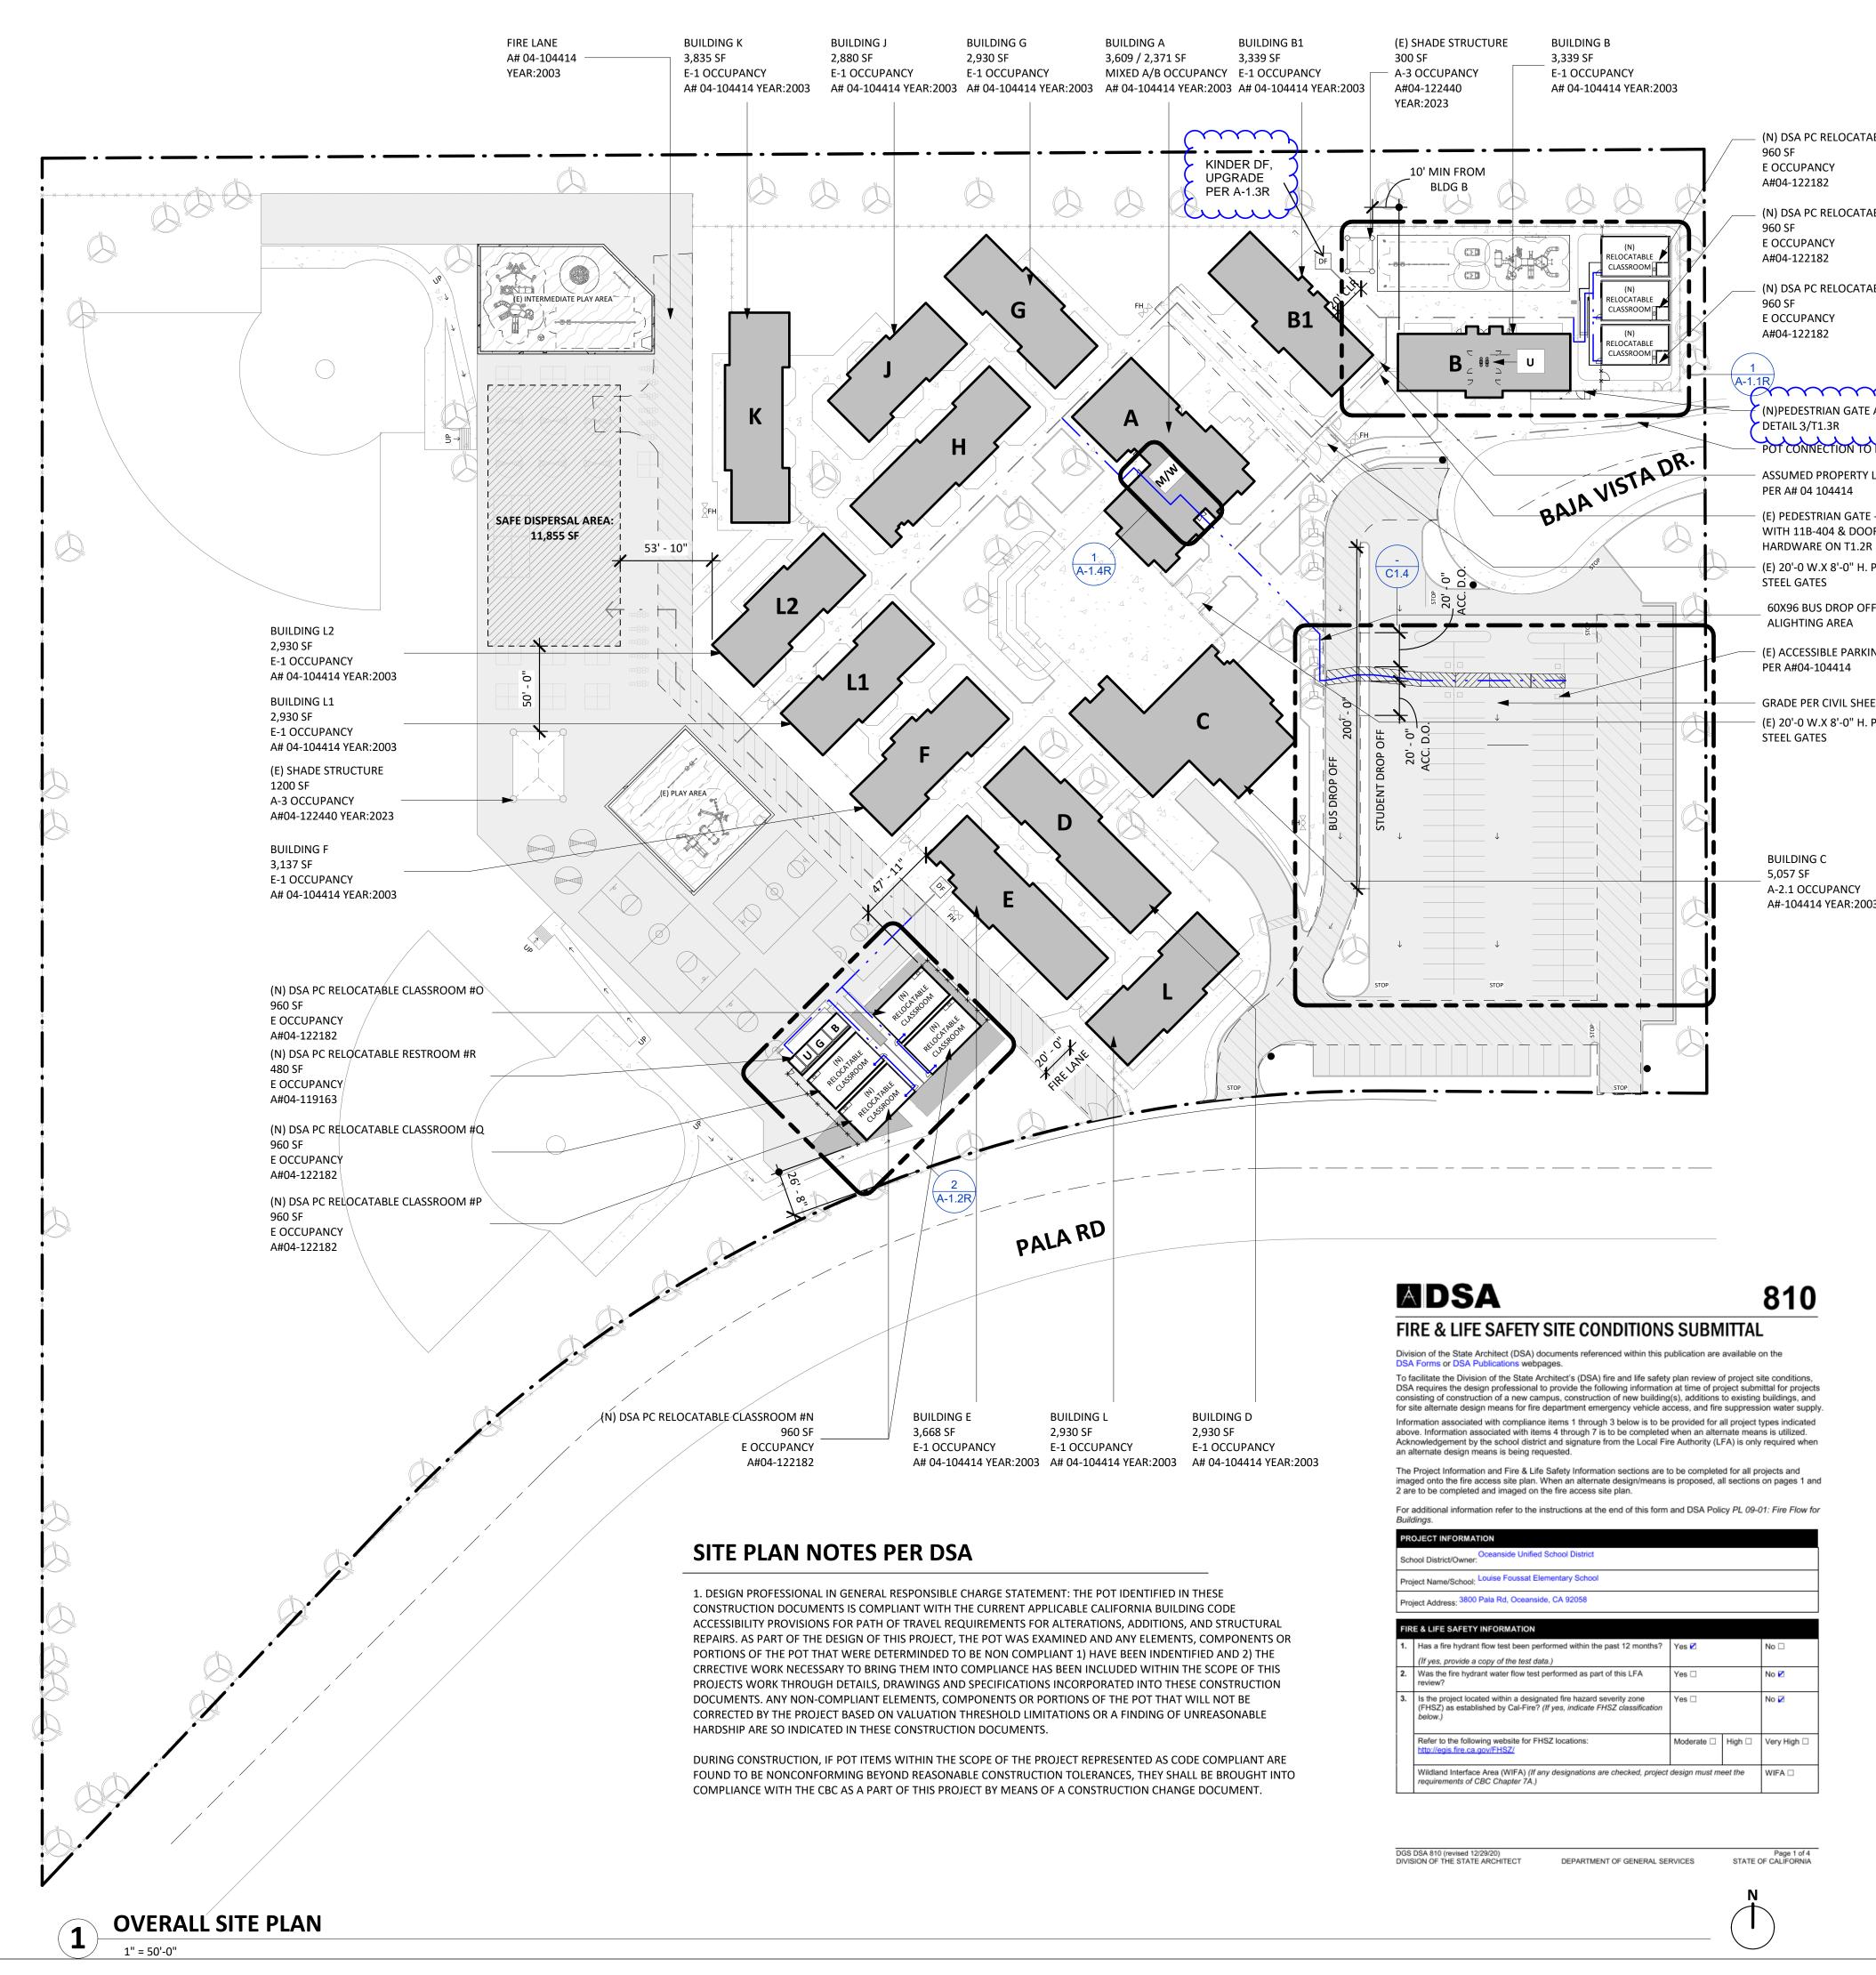


	GENERAL	NOTES						
	 ALL ITEMS ARE SEE PC DRAWIN CONTRACTORS 	(E) U.N.O. IGS FOR CLASSROOM BIDDING OR PERFOR	I BUILDING LAYOU MING WORK SHA	JTS. ALL VERIFY THE	SITE ACCESSIBILITY NO CONDITIONS OF THE S ORK AND SHALL NOTIF	TES. DIV. OF APP. 0	REVIEWED FOR	
BLE CLASSROOM #B2	5. REFERENCE ELE IN THIS CONTRA	ACT.	FOR ALL UNDERG	ROUND UTILIT	Y WORK TO BE COMPL	ETED	01/22/2025	
3LE CLASSROOM #B3	(AS REQUIRED).				OSSIBLE INTERRUPTION			
		ONAL REQUIREMENT			IENTS OF THE TESTING NCES AND UP TO	LAB		
BLE CLASSROOM #B4	 8. ALL N.I.C. ITEMS 9. PATH OF TRAVE ABRUPT VERTIC LEVEL CHANGES RESISTANT, STA THE DIRECTION MAINTAIN FREE OBJECTS GREAT 	S INDICATED ON PLAI (L, (P.O.T.) AS INDICA AL CHANGES EXCEED DO NOT EXCEED 1/4 BLE, FIRM AND SMO OF TRAVEL IS LESS T OF OVERHANGING (ER THAN 4" PROJECT	TED IS A BARRIER DING 1/2" BEVELE 4" VERT. AND IS A OTH. CROSS-SLOI HAN 5% UNLESS OBSTRUCTIONS T TON FROM WALL	FREE ACCESS D AT 1:2 MAXI T LEAST 48" W PE DOES NOT E OTHERWISE IN O 80" MINIMU AND ABOVE 2	OVAL. ROUTE WITHOUT ANY MUM SLOPE, EXCEPT T 'IDE. SURFACE IS SLIP 'XCEED 2% AND SLOPE DICATED. (P.O.T.) SHAL M AND PROTRUDING 7" AND LESS THAN 80" EL HAVE BEEN REMOVI	IN L		
AT (N) P.O.T. SEE		AOVED UNDER THIS I	PROJECT.					
UBLIC SIDEWALK	PLAN LEG	END					WE C. M	
NE		PROPERTY LINE					★ No. 33077	
OMPLIES &		ASSUMED PROPE	RTY LINE PER A# (04 104414			STR. UN 30	S N N
		AREA OF WORK					Contraction of CALIF	OK
IR	X X X	(N) 6' CHAINLINK						
	× × ×	CHAINLINK FENCE			£			
i		— (E) PATH OF TRAV	'EL PER A# 04-104	1414				ART EVE
		– (N) PATH OF TRAN	/EL					CTURE
S C1.1, C1.4	•	EXISITING TOW A	WAY SIGNS NEED	TO BE REPLAC	ED SEE DETAIL 7/T1.3R		C	ARCHITE
IR		BUILDING TO REM	IAIN, PROTECT IN	I PLACE			C	
		CONCRETE TO REM	MAIN, PROTECT II	N PLACE				
		ASPHALT TO REM	AIN, PROTECT IN	PLACE				ANSI Monte
		LANDSCAPE TO RE	EMAIN, PROTECT	IN PLACE				
		SAFE DISPERSAL A	REA PER A# 04-10	04414				
		20' WIDE FIRE ACC	CESS LANE PER A#	‡ 04-104414			UNIFIED	
		INDICATES LOCAT PER A#04-104414		(ING FOUNTAII	N		DE UNIFI DISTRIC	
		TREE TO REMAIN	- PROTECT IN PLA	ACE			OCEANSIDE SCHOOL D	
		FIRE HYDRANT PE	R A# 04-104414				SC	
	G	GIRLS STUDENT RI	ESTROOM	Μ	MENS STAFF RESTRO	MO MOC	U	
	В	BOYS STUDENT RE	STROOM	U	UNISEX STAFF RESTRO	Brepar Brepar		
	w	WOMENS STAFF F	RESTROOM	DF	DRINKING FOUNTAIN			
	BUILDIN	G CODE AI	NALYSIS				<u>ل</u> ـ	
	CODE REFERENC	FS: 2022 CBC. C	CR TITLE 24, PAR	T 2			00	
		TIONS- KINDER AREA					RE	
	STRUCTURE			ALLOWABLE	HEIGHT ALLOWABLE A	REA	TU TU	058
	(N) BUILDING #B2	2 960 SF E	V-B	40 FT	9,500 SF		<u>AR</u> UC	A 92
	(N) BUILDING #B3 (N) BUILDING #B4		V-B V-B	40 FT 40 FT	9,500 SF 9,500 SF		TR	le, C
	(E) BUILDING B	3,339 SF E	V-B	40 FT	9,500 SF	ER J	ELEMENTARY SCHOOL INFRASTRUCTURE	d, Oceanside, CA 92058
	TOTAL:	6,219 SF			3,281 SF UND		JFR)cea
	STRUCTURE (N) BUILDING #N	AREA OCC. GRO 960 SF E	V-B	40 FT	HEIGHT ALLOWABLE A 9,500 SF		SAT AR	Pala R
	(N) BUILDING #O		V-B	40 FT 40 FT	9,500 SF	0		3800 Pala R
	(N) BUILDING #R (N) BUILDING #Q		V-B V-B	40 FT 40 FT	9,500 SF 9,500 SF		E FOUS	30
	(N) BUILDING #R TOTAL:	484 SF N/A 4,324 SF	V-B	40 FT	9,500 SF 5,176 SF UND	FR	SE	
					3,170 31 0100		LOUISE FOUSSAT MODULAR	
					# OF ACCESSION		Γ	
		AKKING	MIN ACCESSI SPACES REQ		# OF ACCESSIBLE SPACES PROVIDED			0.10-
	TOTAL # OF F				6 (1 VAN REQ'D)	PROJEC	I NU.	OUSD-
	TOTAL # OF F		5 (INCLUDING 1	L VAN)	6 (I VAN REQ D)			
	TOTAL # OF F SPACE 133		5 (INCLUDING 1	L VAN)		FILE NA	ME	
	TOTAL # OF F SPACE 133 FLOOD ZC Per flood map th	S ONE NOTES	5 (INCLUDING 1		9. Per DSA PR 14-01,			
	TOTAL # OF F SPACE 133 FLOOD ZC <u>Per flood map th</u> <u>section 2.1 provi</u> The flood zone d	S DNE NOTE: ne site is located with ide: esignation: A99	5 (INCLUDING 1 S nin special hazaro			FILE NA	NS SHE	ET NO.
	TOTAL # OF F SPACE 133 FLOOD ZC <u>Per flood map th</u> <u>section 2.1 provi</u> The flood zone d RIFM panel desig Effective date of	S DNE NOTES ne site is located with ide:	5 (INCLUDING 1 S hin special hazaro			REVISIO	NS SHE	TET NO. \-1.0F


9/30/2024 11:38:02 AM Copyright obrARCHITECTURE, Inc.

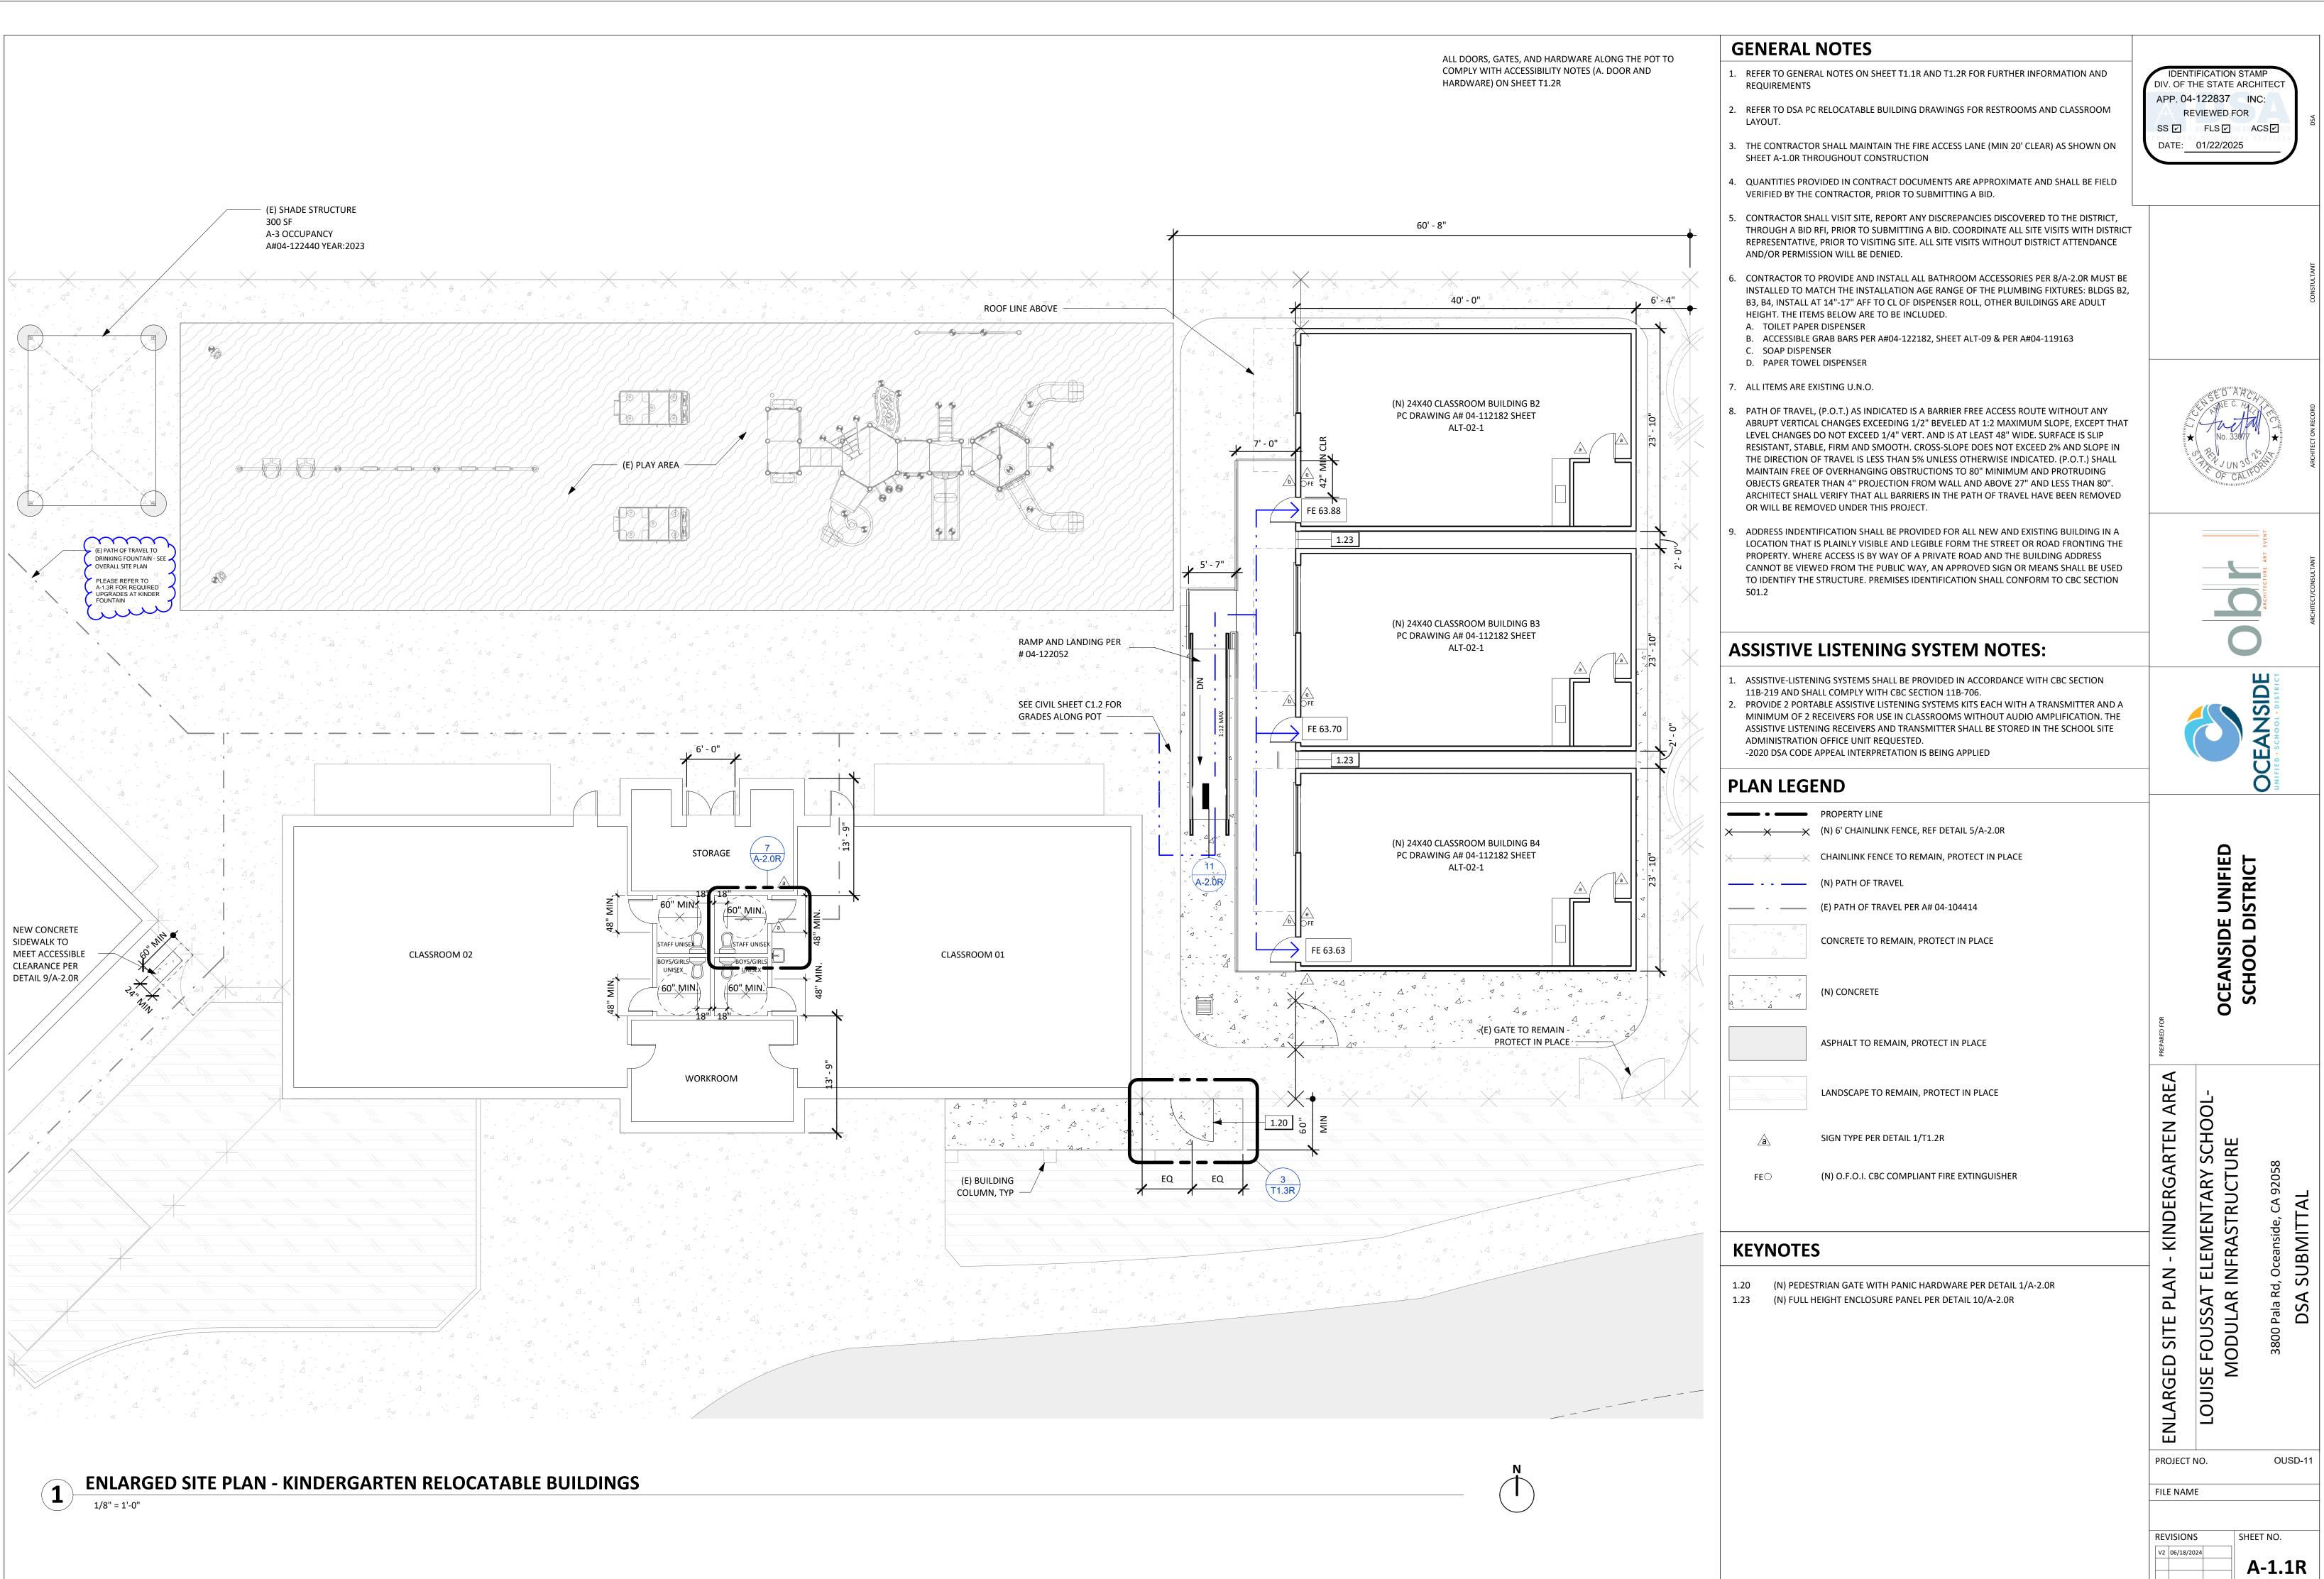

9/30/2024 11:38:05 AM Copyright obrARCHITECTURE, Inc.

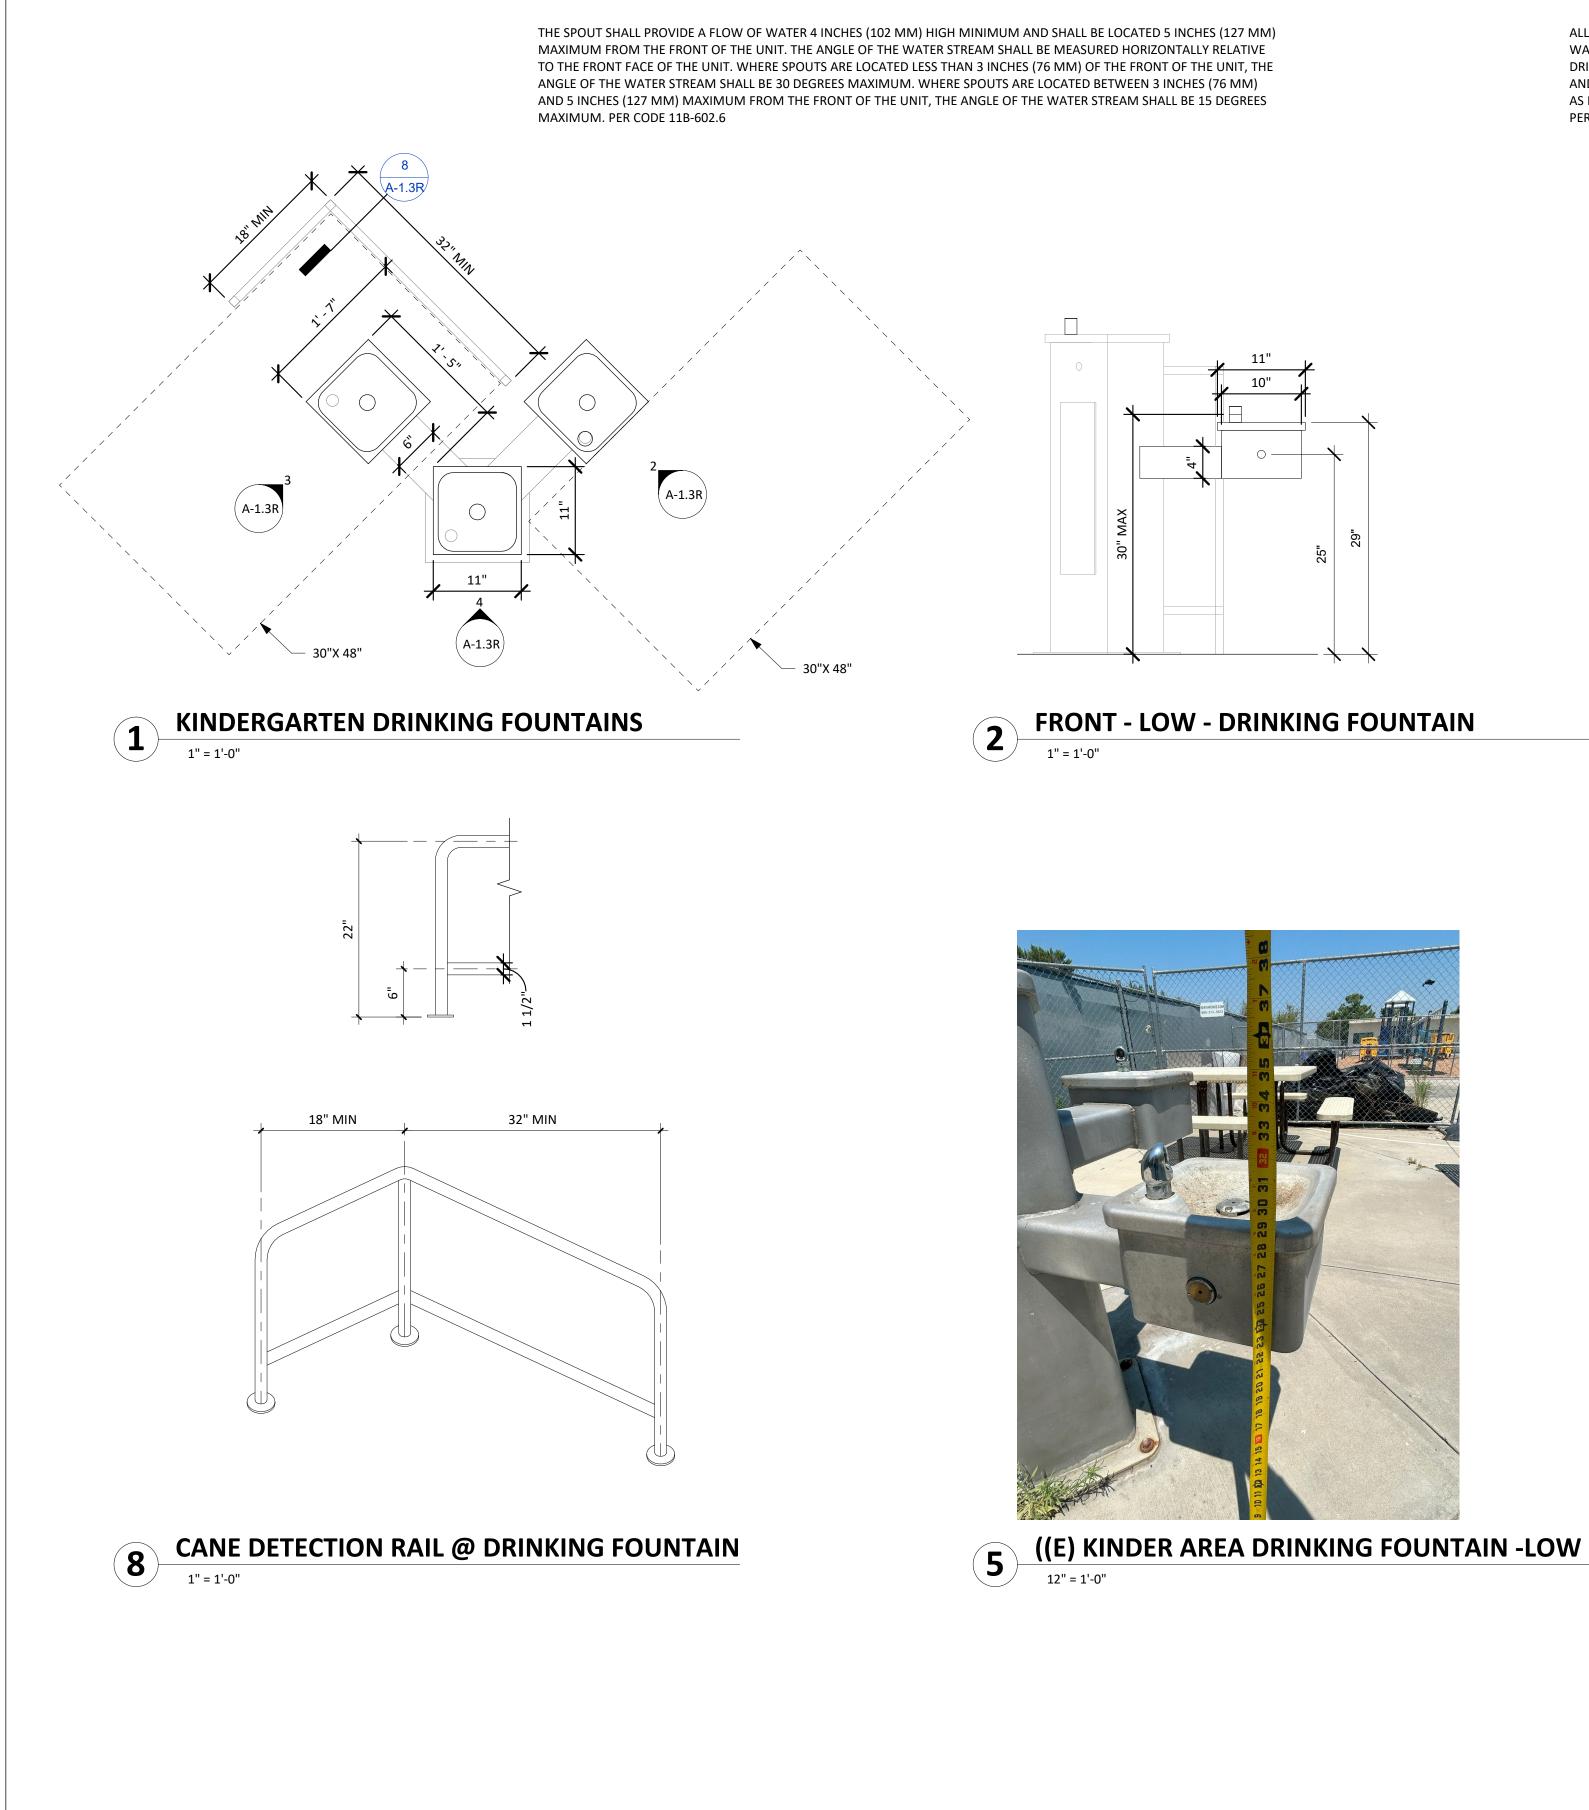


ALL DRINKING FOUNTAINS SHALL EITHER BE LOCATED COMPLETELY WITHIN ALCOVES, POSITIONED COMPLETELY BETWEEN WING WALLS, OR OTHERWISE POSITIONED SO AS NOT TO ENCROACH INTO PEDESTRIAN WAYS. THE PROTECTED AREA WITHIN WHICH A DRINKING FOUNTAIN IS LOCATED SHALL BE 32 INCHES (813 MM) WIDE MINIMUM AND 18 INCHES (457 MM) DEEP MINIMUM, AND SHALL COMPLY WITH SECTION 11B-305.7. WHEN USED, WING WALLS OR BARRIERS SHALL PROJECT HORIZONTALLY AT LEAST AS FAR AS THE DRINKING FOUNTAIN AND TO WITHIN 6 INCHES (152 MM) VERTICALLY FROM THE FLOOR OR GROUND SURFACE. PER CODE 11B-602.9

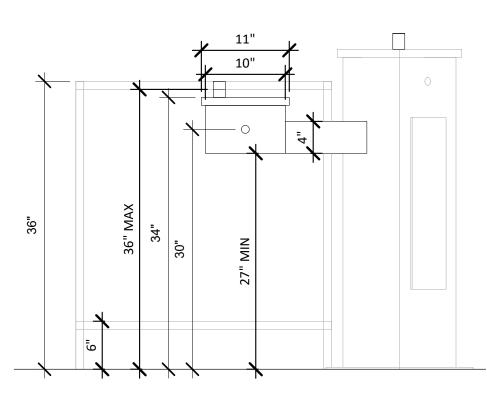





6 ((E) KINDER AREA DRINKING FOUNTAIN- MID

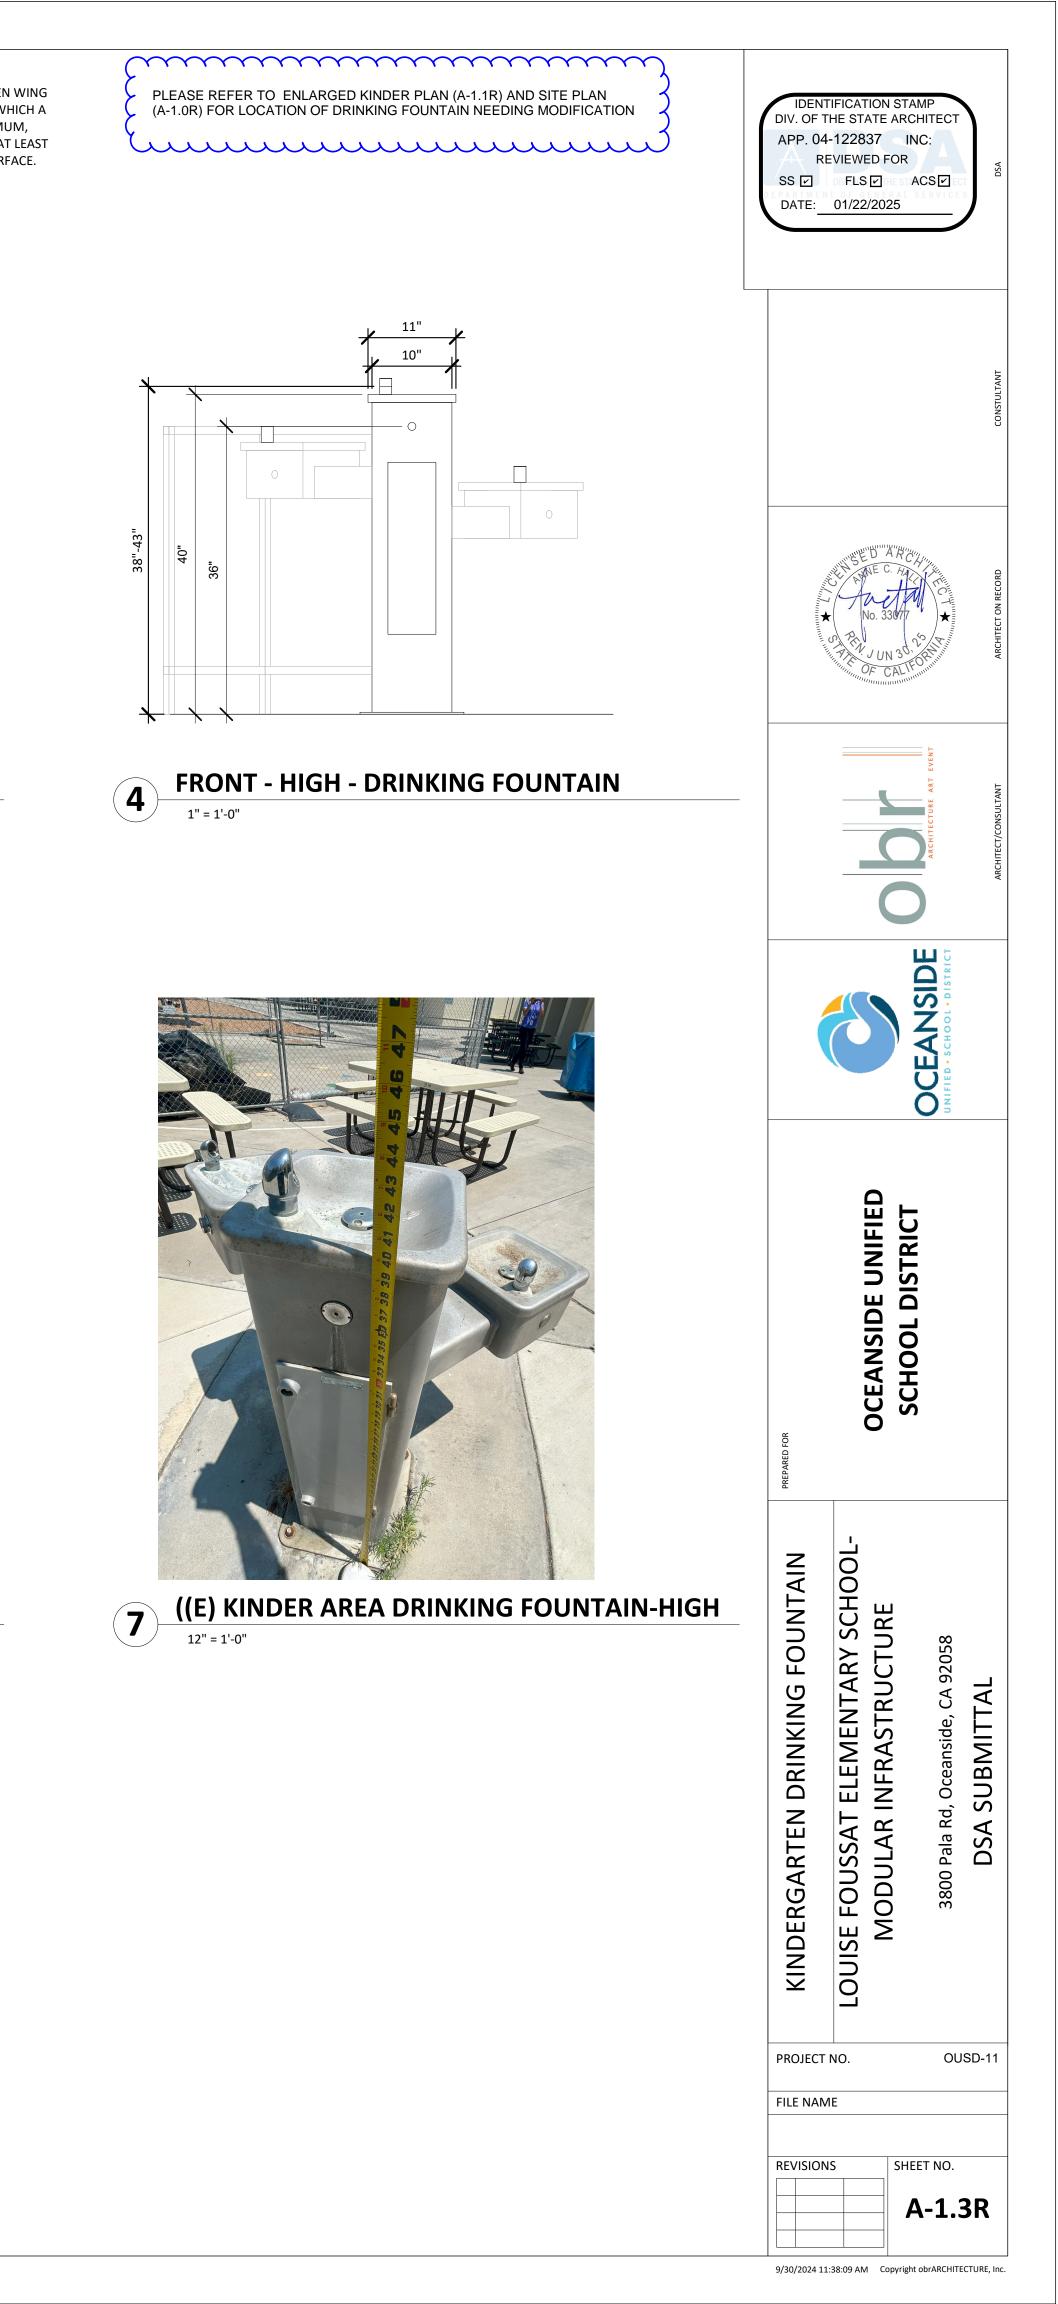

Attachment B



Oceanside USD 2111 Mission Ave Oceanside, California 92054 P: (760) 966-4421

RFI #2: Pre-bid Scope Clarifications

Status	Closed on 04/09/25		
То	Corrisa Bolls (MAAS)	From	Corrisa Bolls (MAAS)
Date Initiated	Apr 9, 2025	Due Date	Apr 9, 2025
Location		Project Stage	
Cost Impact		Schedule Impact	
Spec Section			
Drawing Number	C1.1, C1.6, C1.5	Reference	
Linked Drawings			
Received From			
Copies To	Corrisa Bolls (MAAS)		
Revision			

Activity	
Question	Question from Corrisa Bolls MAAS on Wednesday, Apr 9, 2025 at 01:12 PM PDT
	Multiple questions regarding the scope of work required, as it pertains to the attached Civil sheets. Sheet - C1.1 I have a reference to sheet C1.2 as well. Questions:
	 This area was still requesting truncated domes but since there are existing truncated domes I wanted to understand if we can keep the existing truncated domes. I have a lot of dimensions provided since I feel like there are maneuverable clearance requirements. If you have a code I can reference or if you want to markup my dimensions to show what is needed in certain areas that would help. If you need any other photos or dimensions, please let me know.
	Sheet - C1.4 is now C1.2: I have some dimensions and highlights for the areas in question. Questions:
	 The images show that we do not have 5' of sidewalk on either side of the sidewalk due to the existing fence. Please clarify if 5' is a minimum requirement for the sidewalk. (This will help me determine the scope needed for the existing fence at both sides.) There appears to be a space between where the truncated domes were needed vs where the sidewalk striping starts. Please clarify if there is a minimum amount of spacing between the asphalt striping and sidewalk striping. You will see that one of the sidewalks already has striping that is 20' but that is dependent on the existing spacing shown. Please note, if there is a clearance requirement to obtain the 20', I may run into conflicts with the existing light post. Please clarify if you want the opposite side of the pathway that does not have striping to mirror the sidewalk that already has striping. I have 3 options available on the attached C1.4 AKA C1.2 for your input.
	Sheet - C1.5 - Photos of the parking lot already have striping and signs. Questions:
	 Detail 2 - Is the 3' spacing a hard dimension? I have about 2'5" from edge of wheel stop to the striping. (Which is about where the ADA sign is located.) Maybe the 3' is based on the spacing between the two wheel stops not the striping like I measured, please let me know. Detail 3 - Does the ADA Parking stencil need to be solid white at the edges, the existing has spaces.
	Sheet - C1.6 - Some more existing conditions Questions:
	 Detail 4 - Please confirm it is acceptable that the existing wheel stops are 7" not 9". Detail 5 - Please clarify if it is acceptable, we keep the existing parking sign poles, since we are not planning to need to cut up the parking lot. Detail 5 - I have images of how the existing poles have multiple signs attached to them. If we can keep the poles, please let me know if it is acceptable we use the existing application to install multiple signs on the poles.
	Attachments C1.6 ADA Details MU.pdf, C1.1_ DEMOLITION PLAN Rev.V3 MU.pdf, C1.5_ ADA DETAILS Rev.V3 MU.pdf, C1.4_ FOUSSAT LOT PRECISE GRADING Rev.V3 MU.pdf
Official Response	Response from Corrisa Bolls MAAS on Wednesday, Apr 9, 2025 at 01:17 PM PDT
	Civil Engineer Latitude 33 clarifications attached.
	Attachments 2025_0130_Foussat General Qs_Maas-L33 Responses.pdf
All Replies	Response from Corrisa Bolls MAAS on Wednesday, Apr 9, 2025 at 01:17 PM PDT
	Civil Engineer Latitude 33 clarifications attached.
	Attachments

2025_0130_Foussat General Qs_Maas-L33 Responses.pdf

Sheet - C1.1 I have a reference to sheet C1.2 as well.

Questions:

- This area was still requesting truncated domes but since there are existing truncated domes I wanted to understand if we can keep the existing truncated domes. I believe this is only referring to the ramp area, and not the demo domes @ the striped asphalt? We need to make sure they meet the standard in the drawings; if they do they can remain. The images make it look like the sloping curb may be a little large/the truncated domes aren't the full width of the ramp.
- 2. I have a lot of dimensions provided since I feel like there are maneuverable clearance requirements. If you have a code I can reference or if you want to markup my dimensions to show what is needed in certain areas that would help. If you need any other photos or dimensions, please let me know. 6" curb ht is fine. 4' min width of ramp is fine. 4' width & 3' depth of top "landing" is fine. For clarity 4 ft depth of landing at the top of the ramp, beyond the grade break. I'm not sure if there is a specific area you are concerned about here, please let me know!

Sheet - C1.4 is now C1.2: I have some dimensions and highlights for the areas in question.

Questions:

- The images show that we do not have 5' of sidewalk on either side of the sidewalk due to the existing fence. Please clarify if 5' is a minimum requirement for the sidewalk. (This will help me determine the scope needed for the existing fence at both sides.) DSA instructed us that the dimension of the sidewalk is from inside face of fence to outside face of curb (we can include the curb in the dimension!) so I think we are ok.
- 2. There appears to be a space between where the truncated domes were needed vs where the sidewalk striping starts. Please clarify if there is a minimum amount of spacing between the asphalt striping and sidewalk striping. You will see that one of the sidewalks already has striping that is 20' but that is dependent on the existing spacing shown. Please note, if there is a clearance requirement to obtain the 20', I may run into conflicts with the existing light post. The plans contemplate removal and replacement of portion of the curb and place a transition curb on the north side drop off, which will in fact be close to the light post.
- 3. Please clarify if you want the opposite side of the pathway that does not have striping to mirror the sidewalk that already has striping. I have 3 options available on

the attached C1.4 AKA C1.2 for your input. If I am understanding correctly, the sidewalk, curb, and painting should mirror the existing side.

Sheet - C1.5 - Photos of the parking lot already have striping and signs.

Questions:


- 1. Detail 2 Is the 3' spacing a hard dimension? I have about 2'5" from edge of wheel stop to the striping. (Which is about where the ADA sign is located.) Maybe the 3' is based on the spacing between the two wheel stops not the striping like I measured, please let me know. Yes.
- 2. Detail 3 Does the ADA Parking stencil need to be solid white at the edges, the existing has spaces. Yes.

Sheet - C1.6 - Some more existing conditions


Questions:

- Detail 4 Please confirm it is acceptable that the existing wheel stops are 7" not 9". No.
- 2. Detail 5 Please clarify if it is acceptable, we keep the existing parking sign poles, since we are not planning to need to cut up the parking lot. Yes, assuming they meet the standard in these drawings.
- 3. Detail 5 I have images of how the existing poles have multiple signs attached to them. If we can keep the poles, please let me know if it is acceptable we use the existing application to install multiple signs on the poles. This is per civil, and these two questions are tied together. The detail allows for attachment of the two required signs for these spaces, Reserved parking and Van Accessible. Signs should be installed with dimensions of details at heights indicated in the detail.

As mentioned, I really want to avoid the necessity of resubmitting DSA due to any of these questions. Depending on your responses it will help me to understand if any of these need to be processed formally. If you need any other photos or dimensions, please let me know. Once I have clarification on these, I can finalize the scope for bid. Please feel free to call to discuss if needed. Thank you for your assistance!

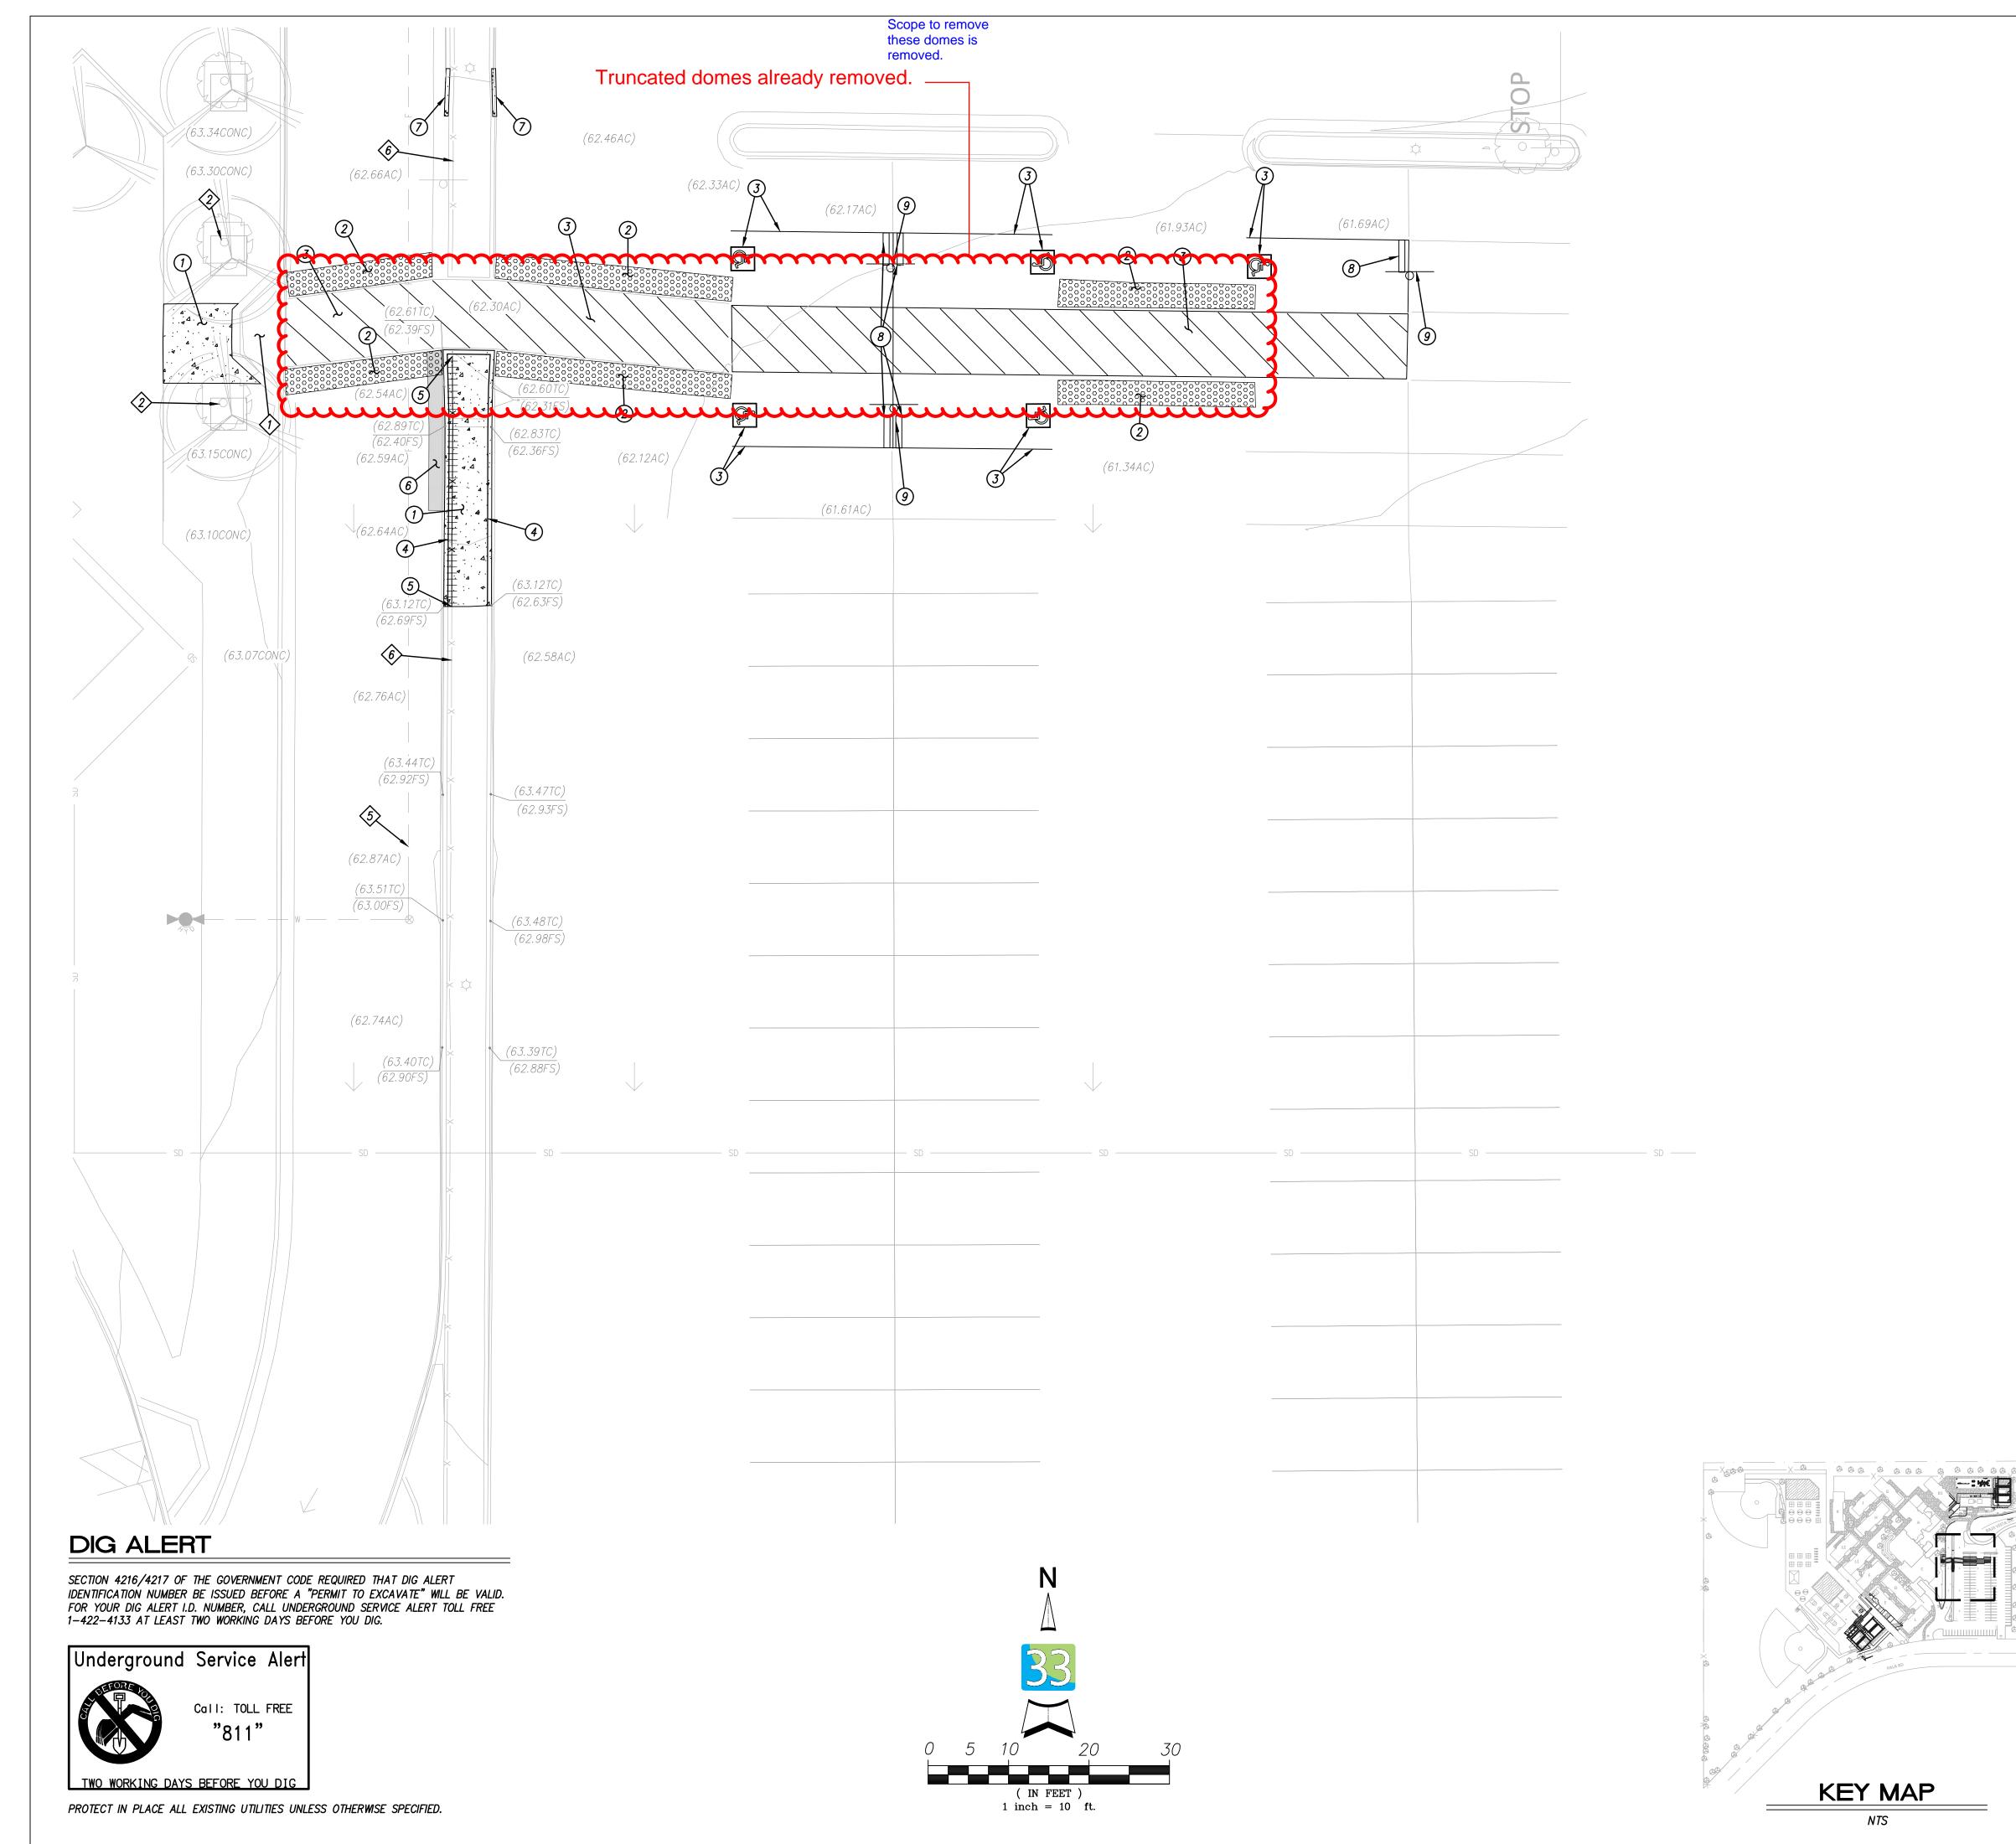


EXISTING FEATURES	63	APP. 04	THE STATE ARC 4-122837 IN	
PCC PAVEMENT			EVIEWED FOR	CSI
ASPHALT PAVEMENT TO BE REMOVED		DATE: _	01/22/2025	
	<u> <u> </u></u>			
DETECTABLE WARNINGS TO BE REMOVED				
CURB AND GUTTER			ED IN D. D.	
FENCE	XX		C79243	
FENCE TO BE REMOVED	+++++++++++++++++++++++++++++++++++++++	REG	Kin	
SIGN & POST	 \\\		CIVIL	OWIT
			CHE.	/
TREES			M	82131
				1 88 1 88 1 88 1 88 1 88 1 88 1 88 1 88
STORM DRAIN PIPE	SD		้ มีการ์	1988년 1988년 1988년
SUBDRAIN PIPE SEWER PIPE	S			Thert Stra
WATER PIPE	W			
FIRE PIPE	F			L Z
GAS PIPE	GAS			ART EVE
SEWER MANHOLE SEWER CLEANOUT	\bigcirc			ECTURE
FIRE HYDRANT	• •		C	ARCHITI
STORM DRAIN INLET				
WATER VALVE	\otimes		C	
ELECTRIC PULL BOX	PB			
ELECTRIC MANHOLE IRRIGATION CONTROL BOX	(RC)			DISTR
IRRIGATION VALVE	®			Ž
LIGHT POLE	-¢-			
FLAG POLE	\bigcirc			
WORK PER SHEET C1.4. (2) REMOVE EXISTING TRUNCATED DO (3) REMOVE AND REPLACE ALL PAVE BY PROPOSED WORK.	CONCRETE TO NEAREST EXISTING JOINT. SEE NEW DMES. IMENT MARKINGS AND STRIPING IN KIND IF AFFECTE	TD	E UNIFIED	
 REMOVE AND REPLACE EXISTING WORK PER SHEET C1.4. REMOVE EXISTING TRUNCATED DC REMOVE AND REPLACE ALL PAVE BY PROPOSED WORK. REMOVE AND REPLACE EXISTING REMOVE AND REPLACE EXISTING REMOVE EXISTING ASPHALT AND REMOVE AND REPLACE WHEEL ST REMOVE AND REPLACE WHEEL ST REMOVE AND REPLACE ACCESSBIL 	CONCRETE TO NEAREST EXISTING JOINT. SEE NEW OMES. MENT MARKINGS AND STRIPING IN KIND IF AFFECTE CURB. FENCING TO NEAREST POST. BASE. ON AND REPLACE CURB PER SHEET C1.4. TOP. LE PARKING SIGN.		OCEANSIDE UNIFIED	
 REMOVE AND REPLACE EXISTING WORK PER SHEET C1.4. REMOVE EXISTING TRUNCATED DC REMOVE AND REPLACE ALL PAVE BY PROPOSED WORK. REMOVE AND REPLACE EXISTING REMOVE AND REPLACE EXISTING REMOVE EXISTING ASPHALT AND REMOVE AND REPLACE WHEEL ST 	CONCRETE TO NEAREST EXISTING JOINT. SEE NEW OMES. IMENT MARKINGS AND STRIPING IN KIND IF AFFECTE CURB. FENCING TO NEAREST POST. BASE. ON AND REPLACE CURB PER SHEET C1.4. TOP. LE PARKING SIGN. ACE NOTES RB RAMP. EE. E WATER LINE.	D. PREPARED FOR		
 REMOVE AND REPLACE EXISTING WORK PER SHEET C1.4. REMOVE EXISTING TRUNCATED DC REMOVE AND REPLACE ALL PAVE BY PROPOSED WORK. REMOVE AND REPLACE EXISTING REMOVE AND REPLACE EXISTING REMOVE AND REPLACE EXISTING REMOVE EXISTING ASPHALT AND REMOVE AND REPLACE WHEEL ST REMOVE AND REPLACE WHEEL ST REMOVE AND REPLACE ACCESSED PROTECT IN PLACE EXISTING TREE PROTECT IN PLACE EXISTING TREE PROTECT IN PLACE EXISTING FIRM PROTECT IN PLACE EXISTING FIRM 	CONCRETE TO NEAREST EXISTING JOINT. SEE NEW OMES. IMENT MARKINGS AND STRIPING IN KIND IF AFFECTE CURB. FENCING TO NEAREST POST. BASE. ON AND REPLACE CURB PER SHEET C1.4. TOP. LE PARKING SIGN. ACE NOTES RB RAMP. EE. E WATER LINE.		L OCEANSIDE SCHOOL DI	
 REMOVE AND REPLACE EXISTING WORK PER SHEET C1.4. REMOVE EXISTING TRUNCATED DC REMOVE AND REPLACE ALL PAVE BY PROPOSED WORK. REMOVE AND REPLACE EXISTING REMOVE AND REPLACE EXISTING REMOVE AND REPLACE EXISTING REMOVE EXISTING ASPHALT AND REMOVE AND REPLACE WHEEL ST REMOVE AND REPLACE WHEEL ST REMOVE AND REPLACE WHEEL ST REMOVE AND REPLACE ACCESSBIN PROTECT IN PLACE EXISTING CUI PROTECT IN PLACE EXISTING TREE PROTECT IN PLACE EXISTING FIRM 	CONCRETE TO NEAREST EXISTING JOINT. SEE NEW MES. MENT MARKINGS AND STRIPING IN KIND IF AFFECTE CURB. FENCING TO NEAREST POST. BASE. ON AND REPLACE CURB PER SHEET C1.4. TOP. LE PARKING SIGN. ACE NOTES RB RAMP. EE. E WATER LINE. NCE. ENERAL NOTES THE WATED OTHERWISE.		L OCEANSIDE SCHOOL DI	
 REMOVE AND REPLACE EXISTING WORK PER SHEET C1.4. REMOVE EXISTING TRUNCATED DC REMOVE AND REPLACE ALL PAVE BY PROPOSED WORK. REMOVE AND REPLACE EXISTING REMOVE AND REPLACE EXISTING REMOVE EXISTING ASPHALT AND REMOVE EXISTING CURB TRANSITI REMOVE AND REPLACE WHEEL ST REMOVE AND REPLACE WHEEL ST REMOVE AND REPLACE WHEEL ST REMOVE AND REPLACE ACCESSBIN PROTECT IN PLACE EXISTING CUR PROTECT IN PLACE EXISTING TRE DEMOLITION GE 1 PROTECT IN PLACE EXISTING FIRE 5 PROTECT IN PLACE EXISTING FIRE 5 PROTECT IN PLACE EXISTING FIRE 5 PROTECT IN PLACE EXISTING FIRE 6 PROTECT IN PLACE EXISTING FIRE 1 PROTECT ALL UTILITIES IN PLACE 2 THE LOCATION OF UNDERGROUND ABOVE GROUND UTILITIES/STRUCT RESPONSIBLE FOR CONDUCTING OF HOLING PRIOR TO COMMENCEMENT EXISTING UTILITIES. CONTRACTOR UNKNOWN UNDERGROUND UTILITIES.	CONCRETE TO NEAREST EXISTING JOINT. SEE NEW MES. MENT MARKINGS AND STRIPING IN KIND IF AFFECTE CURB. FENCING TO NEAREST POST. BASE. ON AND REPLACE CURB PER SHEET C1.4. TOP. LE PARKING SIGN. ACE NOTES RB RAMP. EE. E WATER LINE. NCE. ENERAL NOTES E UNLESS NOTED OTHERWISE. D UTILITIES SHOWN HEREON ARE BASED ON ID RECORD DRAWINGS. ADDITIONAL URES MAY BE ENCOUNTERED. CONTRACTOR IS UNDERGROUND EXPLORATIONS AND POT IT OF WORK TO ENSURE LOCATIONS OF SHALL DOCUMENT ALL UNFORESEEN AND ES ON AS-BUILT DRAWINGS AND SUBMIT THEM UPPORT OF PROJECT CLOSE OUT AND THE	PLAN PREPARED FOR	L OCEANSIDE SCHOOL DI	
 REMOVE AND REPLACE EXISTING WORK PER SHEET C1.4. REMOVE EXISTING TRUNCATED DC REMOVE AND REPLACE ALL PAVE BY PROPOSED WORK. REMOVE AND REPLACE EXISTING REMOVE AND REPLACE EXISTING REMOVE AND REPLACE EXISTING REMOVE EXISTING CURB TRANSITI REMOVE AND REPLACE WHEEL ST REMOVE AND REPLACE WHEEL ST REMOVE AND REPLACE WHEEL ST REMOVE AND REPLACE ACCESSBIN PROTECT IN PLACE EXISTING CUR PROTECT IN PLACE EXISTING TRE PROTECT IN PLACE EXISTING FRM DEMOLITION OF UNDERGROUND ABOVE GROUND STRUCTURES AN UNDERGROUND UTILITIES /STRUCT RESPONSIBLE FOR CONDUCTING OF HOLING PRIOR TO COMMENCEMEN EXISTING UTILITIES. CONTRACTOR UNKNOWN UNDERGROUND UTILITIE TO THE IOR AND THE EOW IN SU ACCEPTANCE OF THE PROJECT E DEMOLITION CALLOUTS IN THIS P BE DONE, NOT AN ITEMIZED ACC MANHOLE, VAULT, ETC. THAT IS OF. CONTRACTOR TO VERIFY SITE OF DEMOLITION AND NOTIFY OUS ENGINEER OF RECORD OF ANY P 	CONCRETE TO NEAREST EXISTING JOINT. SEE NEW MES. MENT MARKINGS AND STRIPING IN KIND IF AFFECTE CURB. FENCING TO NEAREST POST. BASE. ON AND REPLACE CURB PER SHEET C1.4. TOP. LE PARKING SIGN. ACCE NOTES RB RAMP. EE. E WATER LINE. NCE. ENERAL NOTES MATER LINE. NCE. ENERAL NOTES UNLESS NOTED OTHERWISE. O UTILITIES SHOWN HEREON ARE BASED ON ID RECORD DRAWINGS. ADDITIONAL URES MAY BE ENCOUNTERED. CONTRACTOR IS UNDERGROUND EXPLORATIONS AND POT IT OF WORK TO ENSURE LOCATIONS OF SHALL DOCUMENT ALL UNFORESEEN AND ES ON AS-BUILT DRAWINGS AND SUBMIT THEM IPPORT OF PROJECT CLOSE OUT AND THE BY THE DISTRICT. TANSET ARE REPRESENTATIVE OF WHAT IS TO COUNTING FOR EACH PIPE, CATCH BASIN, TO BE DEMOLISHED, REMOVED AND DISPOSED E CONDITIONS PRIOR TO THE COMMENCEMENT D ARCHITECT AND PROJECT MANAGER AND ROPOSED DEVATIONS FROM THESE PLANS. WANAGER AND EOR SHALL BE MADE IN A	PREPARED FOR	ELEMENTARY SCHOOL AR INFRASTRUCTURE SCHOOL SCHOOL DI	CA 92058
 REMOVE AND REPLACE EXISTING WORK PER SHEET C1.4. REMOVE EXISTING TRUNCATED DC REMOVE AND REPLACE ALL PAVE BY PROPOSED WORK. REMOVE AND REPLACE EXISTING REMOVE AND REPLACE EXISTING REMOVE AND REPLACE EXISTING REMOVE EXISTING CURB TRANSITI REMOVE AND REPLACE WHEEL SI REMOVE AND REPLACE ACCESSBIN PROTECT IN PLACE EXISTING CUR PROTECT IN PLACE EXISTING TRE PROTECT IN PLACE EXISTING FIR PROTECT ALL UTILITIES IN PLACE THE LOCATION OF UNDERGROUND ABOVE GROUND STRUCTURES AN UNDERGROUND UTILITIES /STRUCT RESPONSIBLE FOR CONDUCTING OF HOLING PRIOR TO COMMENCEMENT EXISTING UTILITIES. CONTRACTOR UNKNOWN UNDERGROUND UTILITIES THE IOR AND THE EOW IN SU ACCEPTANCE OF THE PROJECT E DEMOLITION CALLOUTS IN THIS P BE DONE, NOT AN ITEMIZED ACC MANHOLE, VAULT, ETC. THAT IS OF DEMOLITION CALLOUTS IN THIS P BE DONE, NOT AN ITEMIZED ACC MANHOLE, VAULT, ETC. THAT IS OF DEMOLITION AND NOTIFY OUS ENGINEER OF RECORD OF ANY P NOTIFICATION TO THE PROJECT M TIMELY MANNER UNAFFECTING TH ANY TEMPORARY ON-SITE EQUIP 	CONCRETE TO NEAREST EXISTING JOINT. SEE NEW MES. MENT MARKINGS AND STRIPING IN KIND IF AFFECTE CURB. FENCING TO NEAREST POST. BASE. ON AND REPLACE CURB PER SHEET C1.4. TOP. LE PARKING SIGN. ACCE NOTES RB RAMP. EE. E WATER LINE. NCE. ENERAL NOTES RB RAMP. EE. E UNLESS NOTED OTHERWISE. D UTILITIES SHOWN HEREON ARE BASED ON ID RECORD DRAWINGS. ADDITIONAL URESS MOTED OTHERWISE. D UTILITIES SHOWN HEREON ARE BASED ON ID RECORD DRAWINGS. ADDITIONAL URESS MOTED OTHERWISE. D UTILITIES SHOWN HEREON ARE BASED ON ID RECORD DRAWINGS. ADDITIONAL URESS MAY BE ENCOUNTERED. CONTRACTOR IS UNDERGROUND EXPLORATIONS AND POT INT OF WORK TO ENSURE LOCATIONS OF SHALL DOCUMENT ALL UNFORESEEN AND ES ON AS-BUILT DRAWINGS AND SUBMIT THEM IPPORT OF PROJECT CLOSE OUT AND THE SY THE DISTRICT. PLANSET ARE REPRESENTATIVE OF WHAT IS TO COUNTING FOR EACH PIPE, CATCH BASIN, TO BE DEMOLISHED, REMOVED AND DISPOSED E CONDITIONS PRIOR TO THE COMMENCEMENT D ARCHITECT AND PROJECT MANAGER AND PROPOSED DEVIATIONS FROM THESE PLANS. MANAGER AND EOR SHALL BE MADE IN A HE PROJECT SCHEDULE. WENT THAT IS DEEMED INTRUSIVE TO THE MILL BE BROUGHT TO THE ATTENTION OF BTAIN APPROVALS PRIOR TO	OLITION PLAN	- ELEMENTARY SCHOOL LAR INFRASTRUCTURE OCEANSIDE SCHOOL DI	OAD, OCEANSIDE, CA 92058
 REMOVE AND REPLACE EXISTING WORK PER SHEET C1.4. REMOVE EXISTING TRUNCATED DO REMOVE AND REPLACE ALL PAVE BY PROPOSED WORK. REMOVE AND REPLACE EXISTING REMOVE AND REPLACE EXISTING REMOVE AND REPLACE EXISTING REMOVE EXISTING ASPHALT AND REMOVE EXISTING CURB TRANSITI REMOVE AND REPLACE WHEEL ST REMOVE AND REPLACE WHEEL ST REMOVE AND REPLACE ACCESSBIN PROTECT IN PLACE EXISTING CUI PROTECT IN PLACE EXISTING TRE PROTECT IN PLACE EXISTING FIRE PROTECT ALL UTILITIES IN PLACE THE LOCATION OF UNDERGROUND ABOVE GROUND STRUCTURES AN UNDERGROUND UTILITIES CONTRACTOR UNKNOWN UNDERGROUND UTILITIES STING UTILITIES. CONTRACTOR UNKNOWN UNDERGROUND UTILITIES DEMOLITION CALLOUTS IN THIS P BE DONE, NOT AN ITEMIZED ACCO MANHOLE, VAULT, ETC. THAT IS OF. CONTRACTOR TO VERIFY SITE OF DEMOLITION CALLOUTS IN THIS P BE DONE, NOT AN ITEMIZED ACCO MANHOLE, VAULT, ETC. THAT IS OF. CONTRACTOR TO VERIFY SITE OF DEMOLITION AND NOTIFY OUS ENGINEER OF RECORD OF ANY P NOTIFICATION TO THE PROJECT M TIMELY MANNER UNAFFECTING TH ANY TEMPORARY ON-SITE EQUIP NOTIFICATION TO THE PROJECT M TIMELY MANNER UNAFFECTING THE CONTRACTOR TO CONFIRM MATER CONTRACTOR TO CONFIRM MATER CONTRACTOR TO CONFIRM MATER 	CONCRETE TO NEAREST EXISTING JOINT. SEE NEW MES. MENT MARKINGS AND STRIPING IN KIND IF AFFECTE CURB. FENCING TO NEAREST POST. BASE. ON AND REPLACE CURB PER SHEET C1.4. TOP. LE PARKING SIGN. ACCE NOTES RB RAMP. EE. E WATER LINE. NCE. ENERAL NOTES RB RAMP. EE. E UNLESS NOTED OTHERWISE. D UTILITIES SHOWN HEREON ARE BASED ON ID RECORD DRAWINGS. ADDITIONAL URESS MOTED OTHERWISE. D UTILITIES SHOWN HEREON ARE BASED ON ID RECORD DRAWINGS. ADDITIONAL URESS MOTED OTHERWISE. D UTILITIES SHOWN HEREON ARE BASED ON ID RECORD DRAWINGS. ADDITIONAL URESS MAY BE ENCOUNTERED. CONTRACTOR IS UNDERGROUND EXPLORATIONS AND POT INT OF WORK TO ENSURE LOCATIONS OF SHALL DOCUMENT ALL UNFORESEEN AND ES ON AS-BUILT DRAWINGS AND SUBMIT THEM IPPORT OF PROJECT CLOSE OUT AND THE SY THE DISTRICT. PLANSET ARE REPRESENTATIVE OF WHAT IS TO COUNTING FOR EACH PIPE, CATCH BASIN, TO BE DEMOLISHED, REMOVED AND DISPOSED E CONDITIONS PRIOR TO THE COMMENCEMENT D ARCHITECT AND PROJECT MANAGER AND PROPOSED DEVIATIONS FROM THESE PLANS. MANAGER AND EOR SHALL BE MADE IN A HE PROJECT SCHEDULE. WENT THAT IS DEEMED INTRUSIVE TO THE MILL BE BROUGHT TO THE ATTENTION OF BTAIN APPROVALS PRIOR TO	OLITION PLAN	FOUSSAT ELEMENTARY SCHOOL MODULAR INFRASTRUCTURE OCEANSIDE	OAD, OCEANSIDE, CA 92058

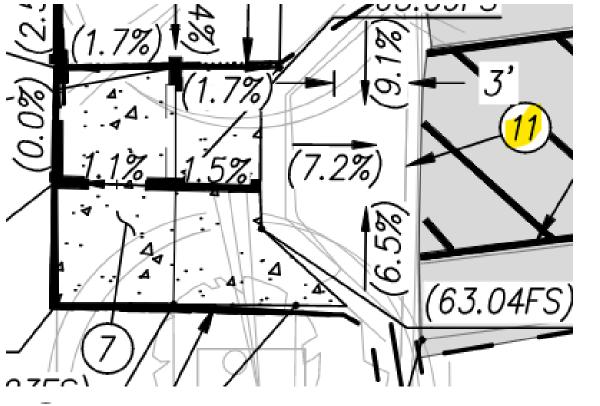

(1) TRUNCATED DOMES PER DETAIL 3 AND SDRSD G-30 | SHEET C1.6 SHEET NO.


C1.2




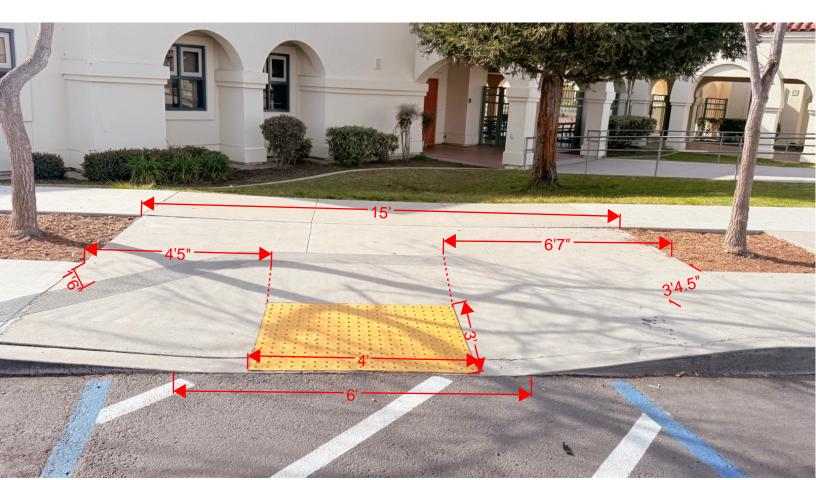






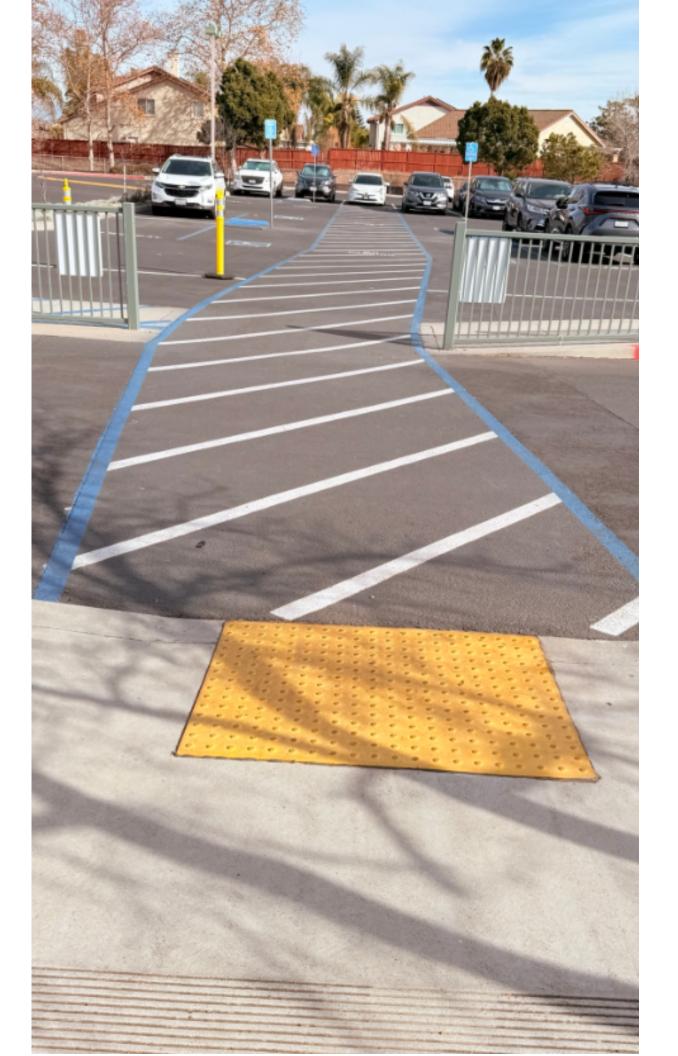


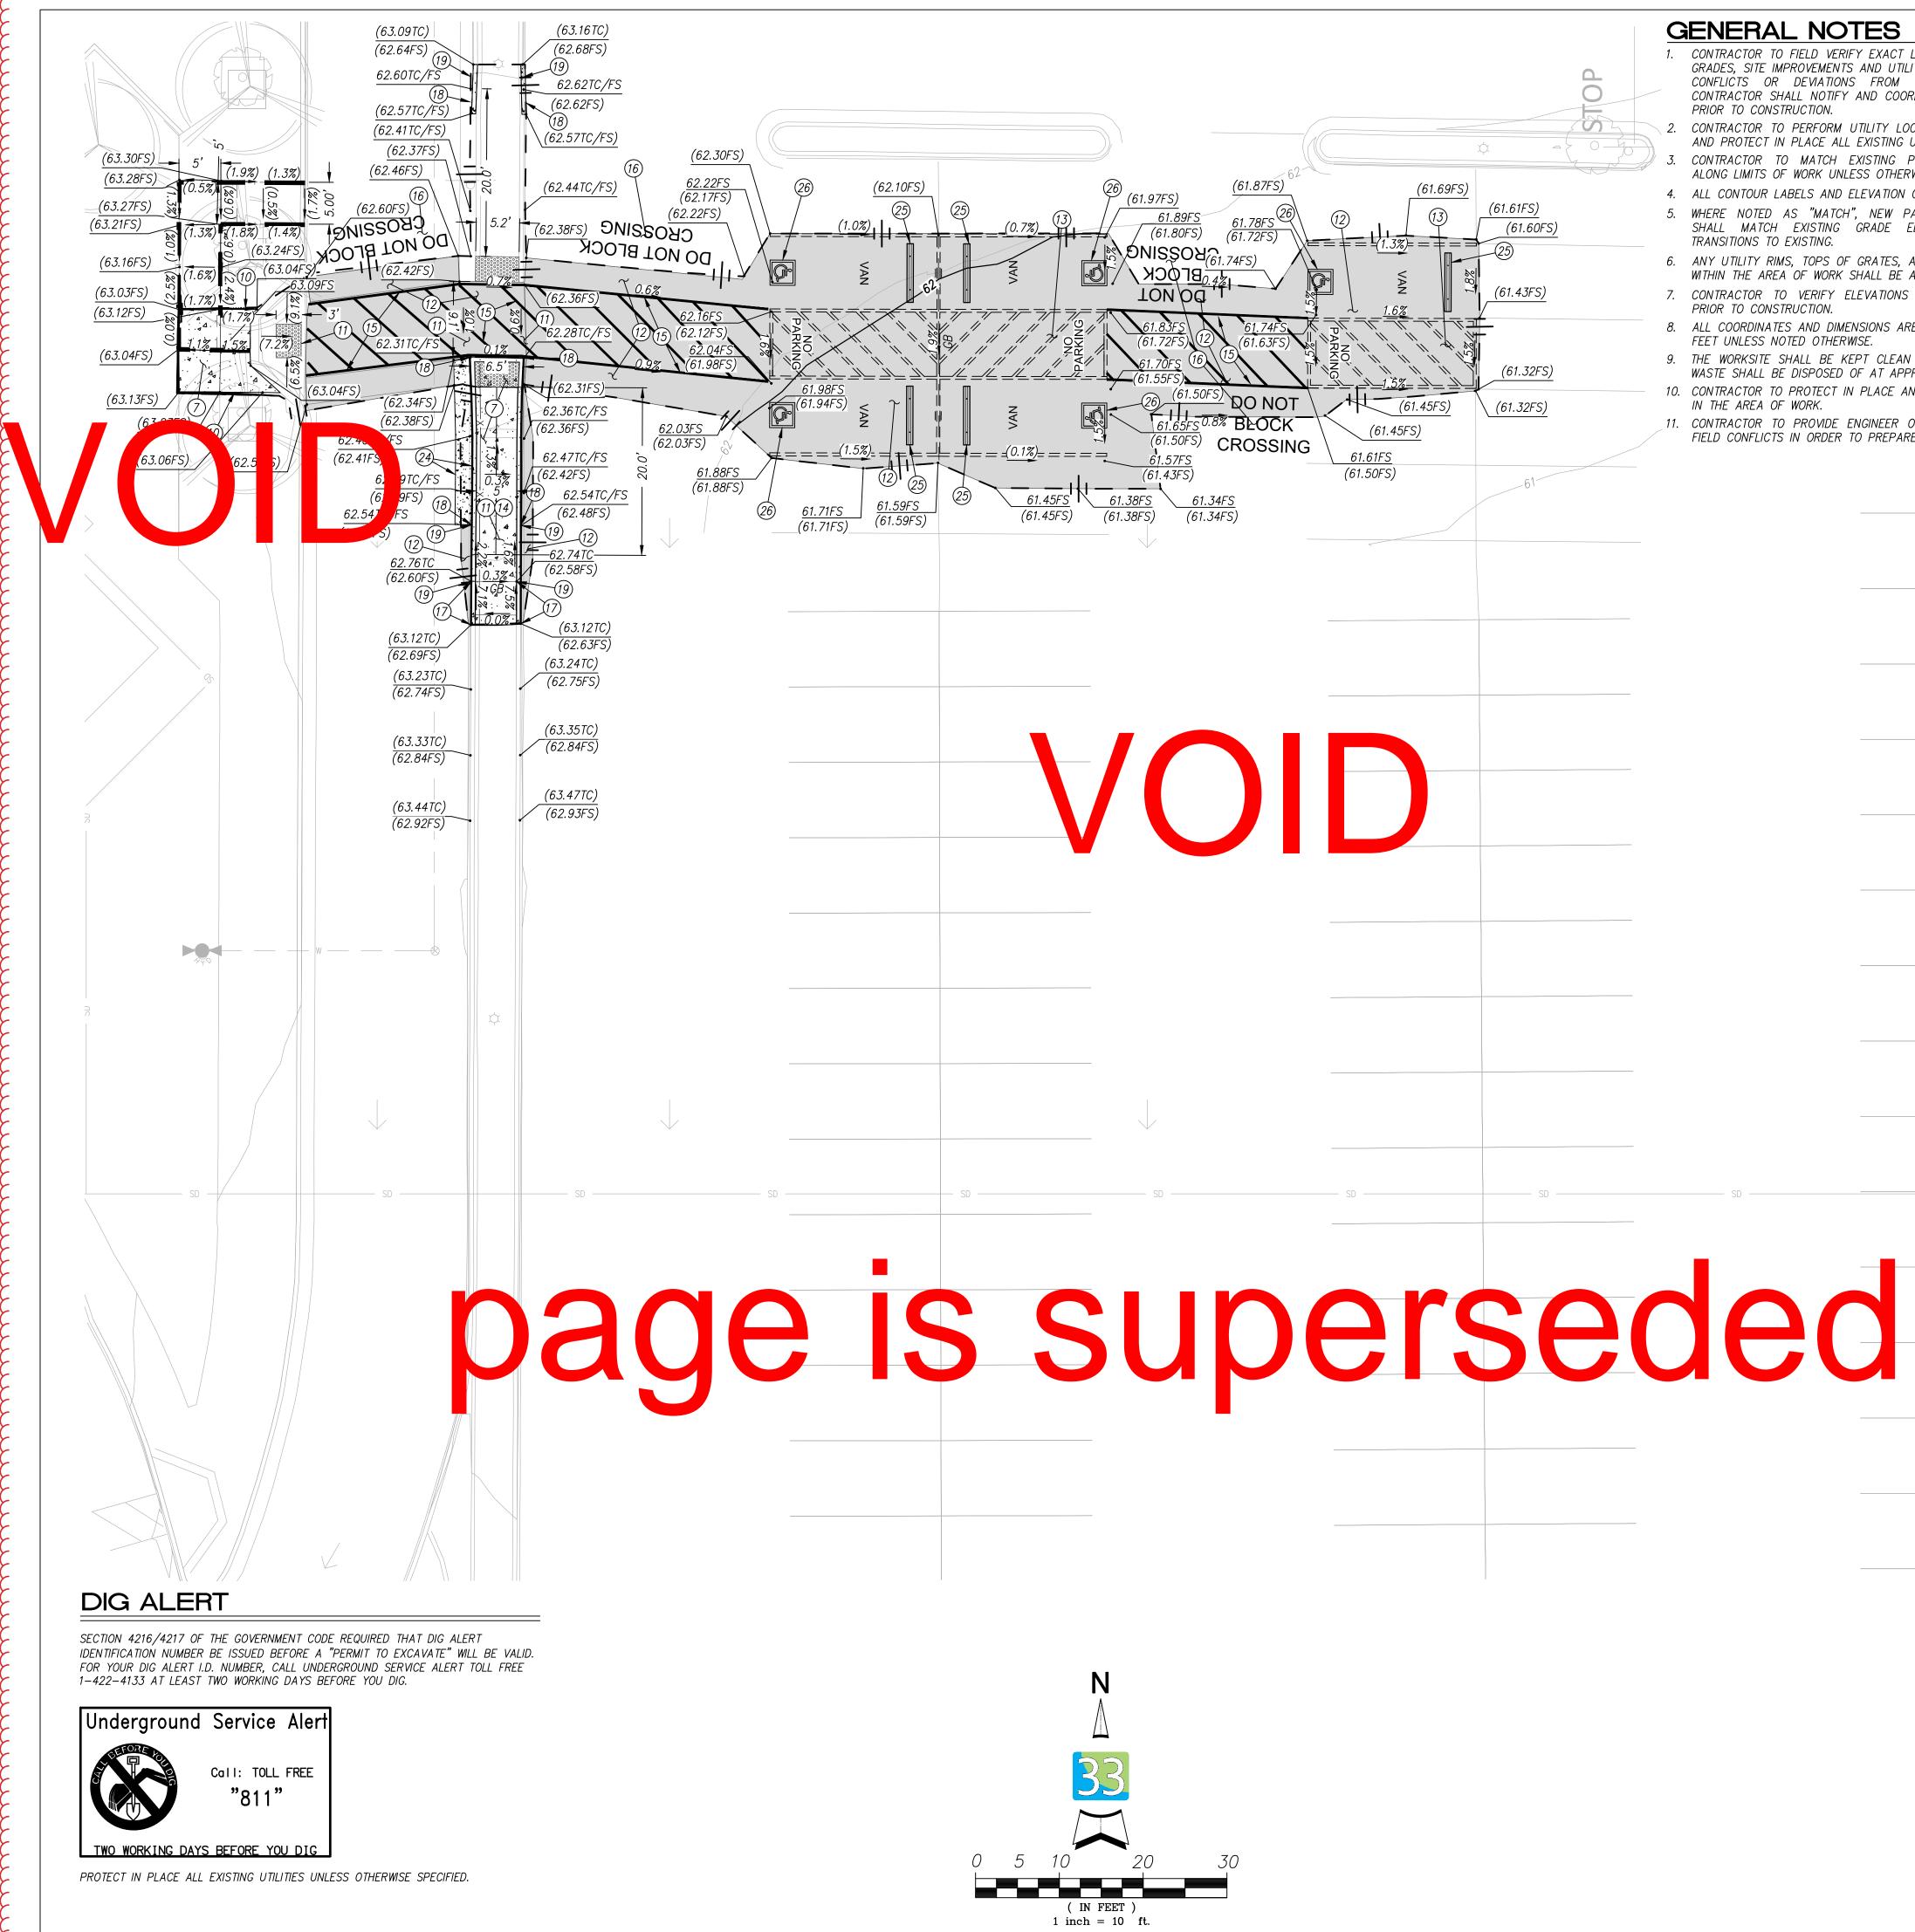

GENERAL NOTES


- CONTRACTOR TO FIELD VERIFY EXACT LOCATION AND ELEVATION OF EXISTING GRADES, SITE IMPROVEMENTS AND UTILITIES PRIOR TO CONSTRUCTION. IF ANY CONFLICTS OR DEVIATIONS FROM THIS PLAN ARE IDENTIFIED, THE CONTRACTOR SHALL NOTIFY AND COORDINATE WITH THE ENGINEER OF WORK PRIOR TO CONSTRUCTION.
- AND PROTECT IN PLACE ALL EXISTING UTILITIES. CONTRACTOR TO MATCH EXISTING PAVEMENT GRADES AND ELEVATIONS
- ALONG LIMITS OF WORK UNLESS OTHERWISE NOTED. ALL CONTOUR LABELS AND ELEVATION CALLOUTS ARE IN UNITS "FEET"
- WHERE NOTED AS "MATCH", NEW PAVEMENTS, SIDEWALKS, AND GRADES SHALL MATCH EXISTING GRADE ELEVATIONS AND PROVIDE SMOOTH TRANSITIONS TO EXISTING.
- ANY UTILITY RIMS, TOPS OF GRATES, AND/OR LIDS (EXISTING OR PROPOSED) WITHIN THE AREA OF WORK SHALL BE ADJUSTED TO GRADE IN THE FIELD.
- 7. CONTRACTOR TO VERIFY ELEVATIONS AT TIE-IN AND/OR MATCH POINTS PRIOR TO CONSTRUCTION. 8. ALL COORDINATES AND DIMENSIONS ARE TO EDGE OF PAVEMENT AND ARE IN
- FEET UNLESS NOTED OTHERWISE. 9. THE WORKSITE SHALL BE KEPT CLEAN OF DEBRIS AND WASTE. DEBRIS AND WASTE SHALL BE DISPOSED OF AT APPROVED SITES.
- 10. CONTRACTOR TO PROTECT IN PLACE ANY AND ALL ROOF DRAIN DOWNSPOUTS IN THE AREA OF WORK.
- 11. CONTRACTOR TO PROVIDE ENGINEER OF WORK SUFFICIENT NOTICE OF ANY FIELD CONFLICTS IN ORDER TO PREPARE FOR DESIGN RESOLUTION.

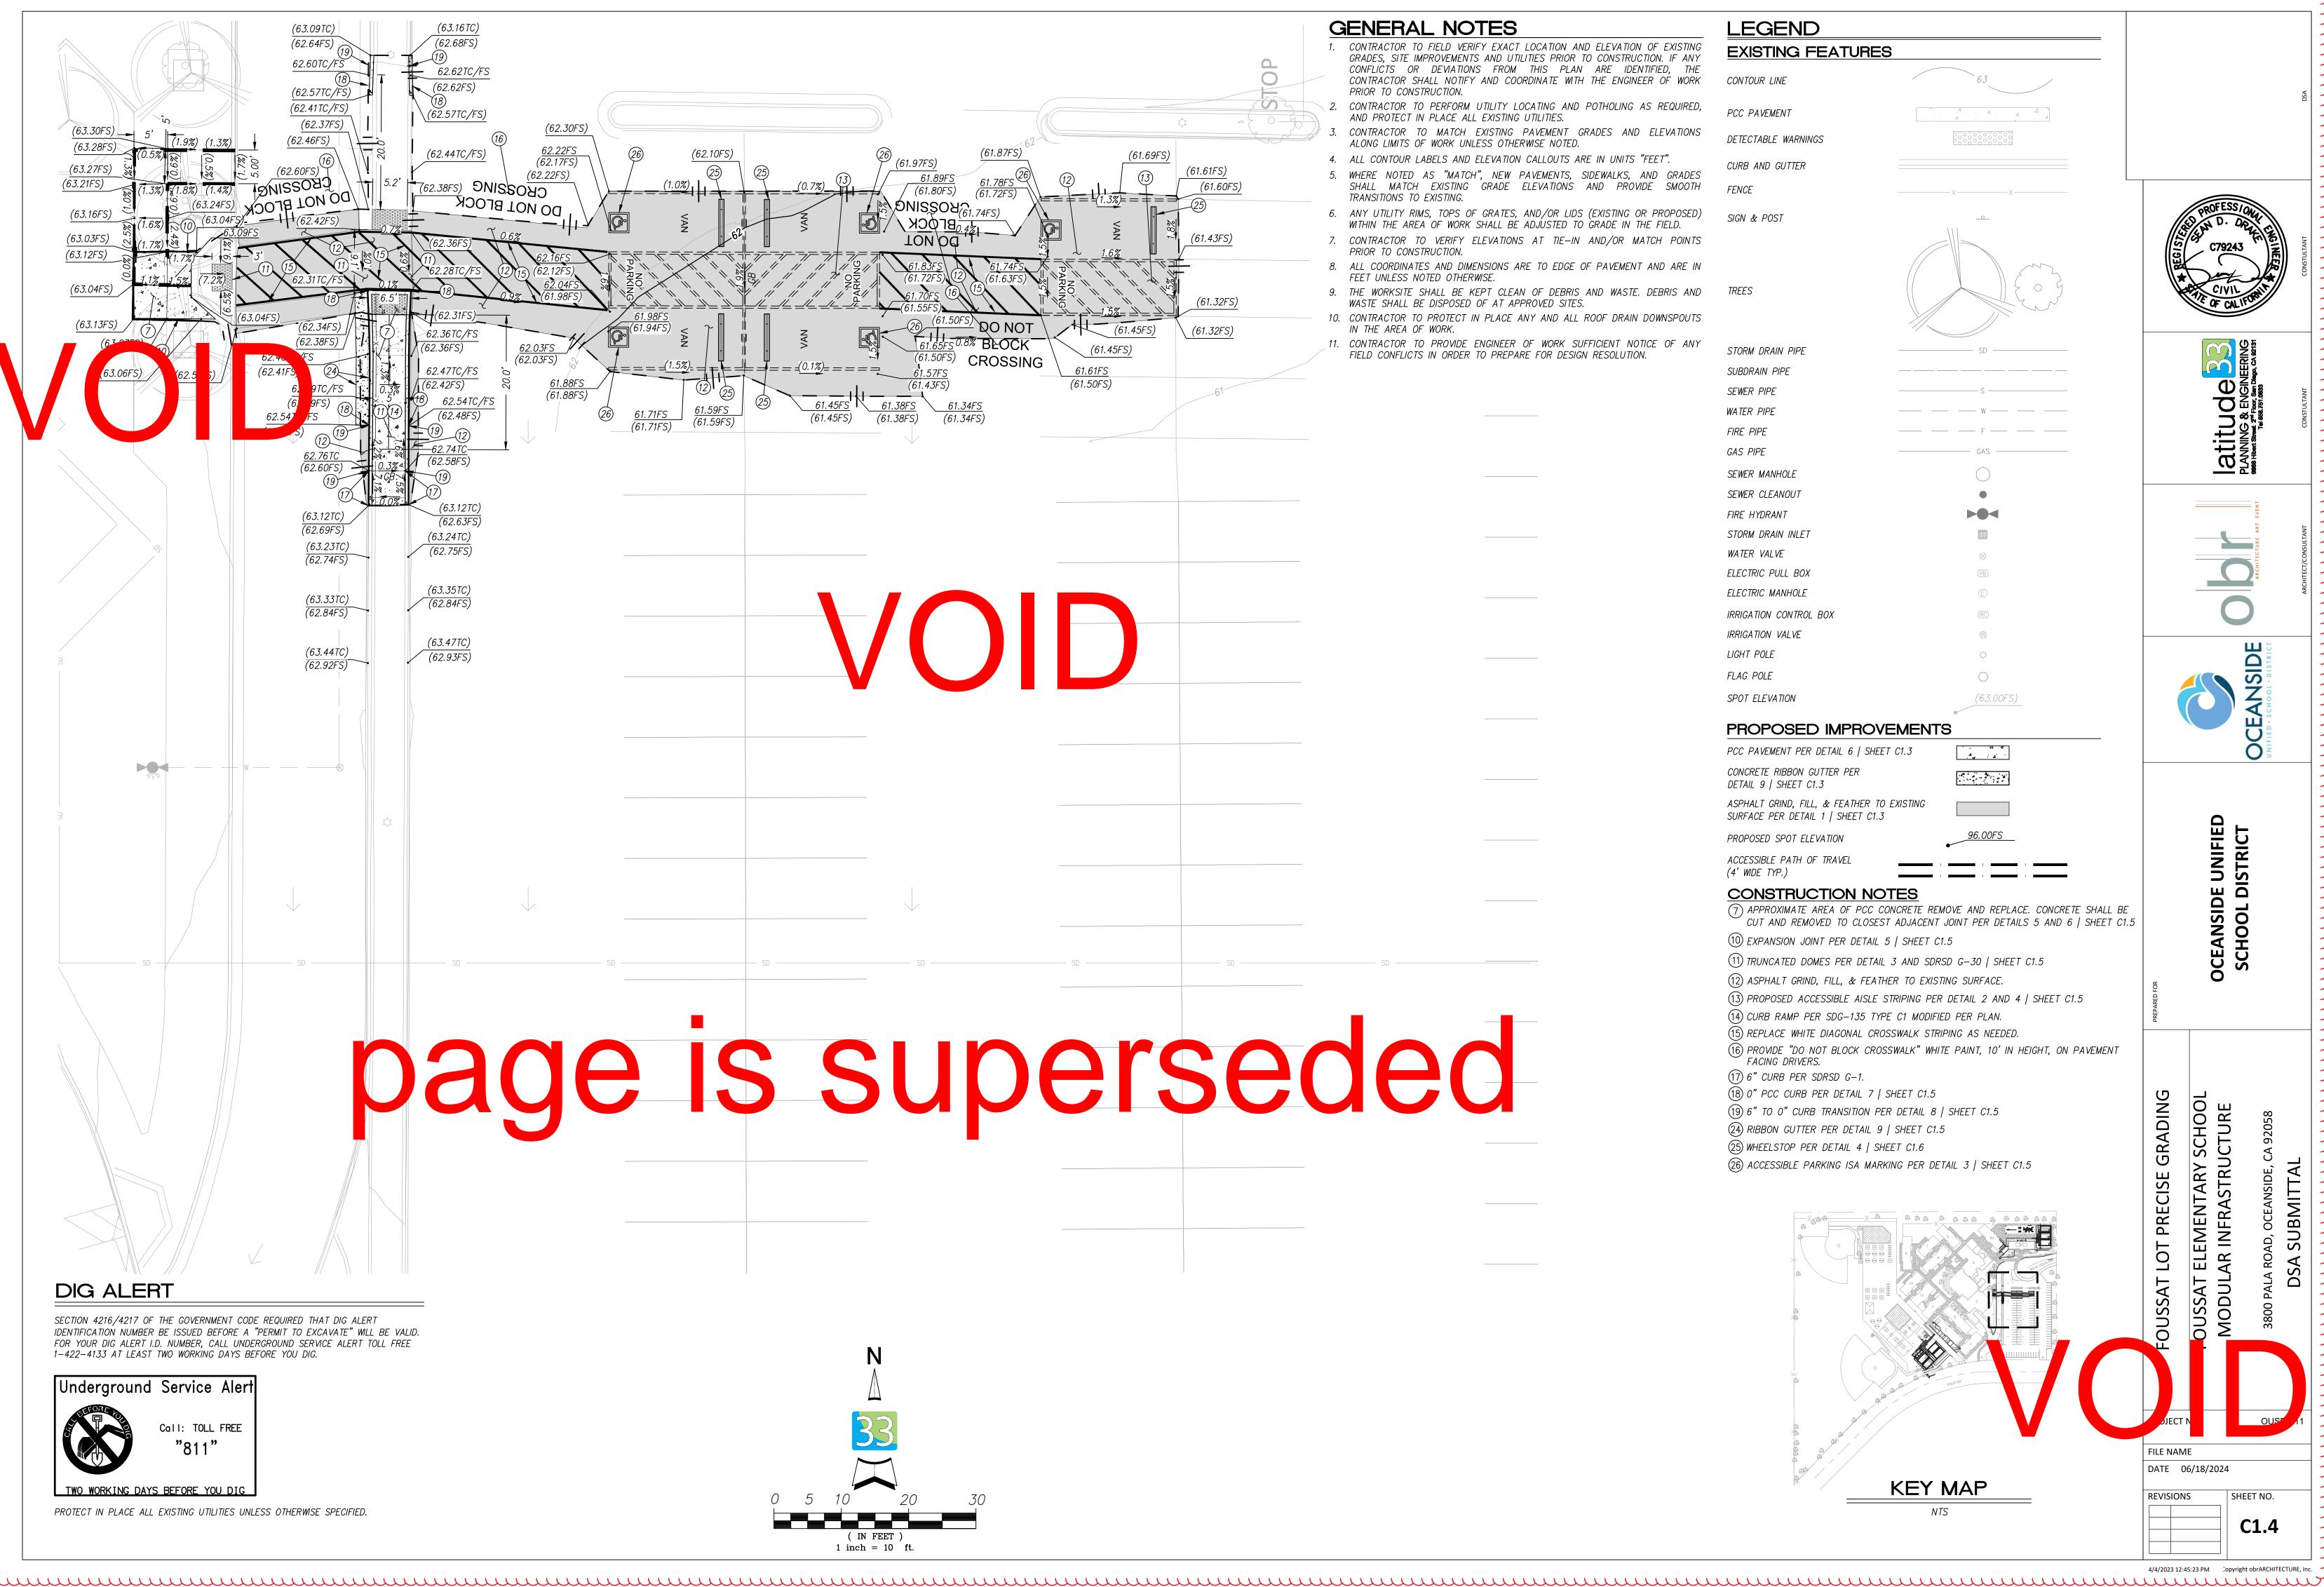

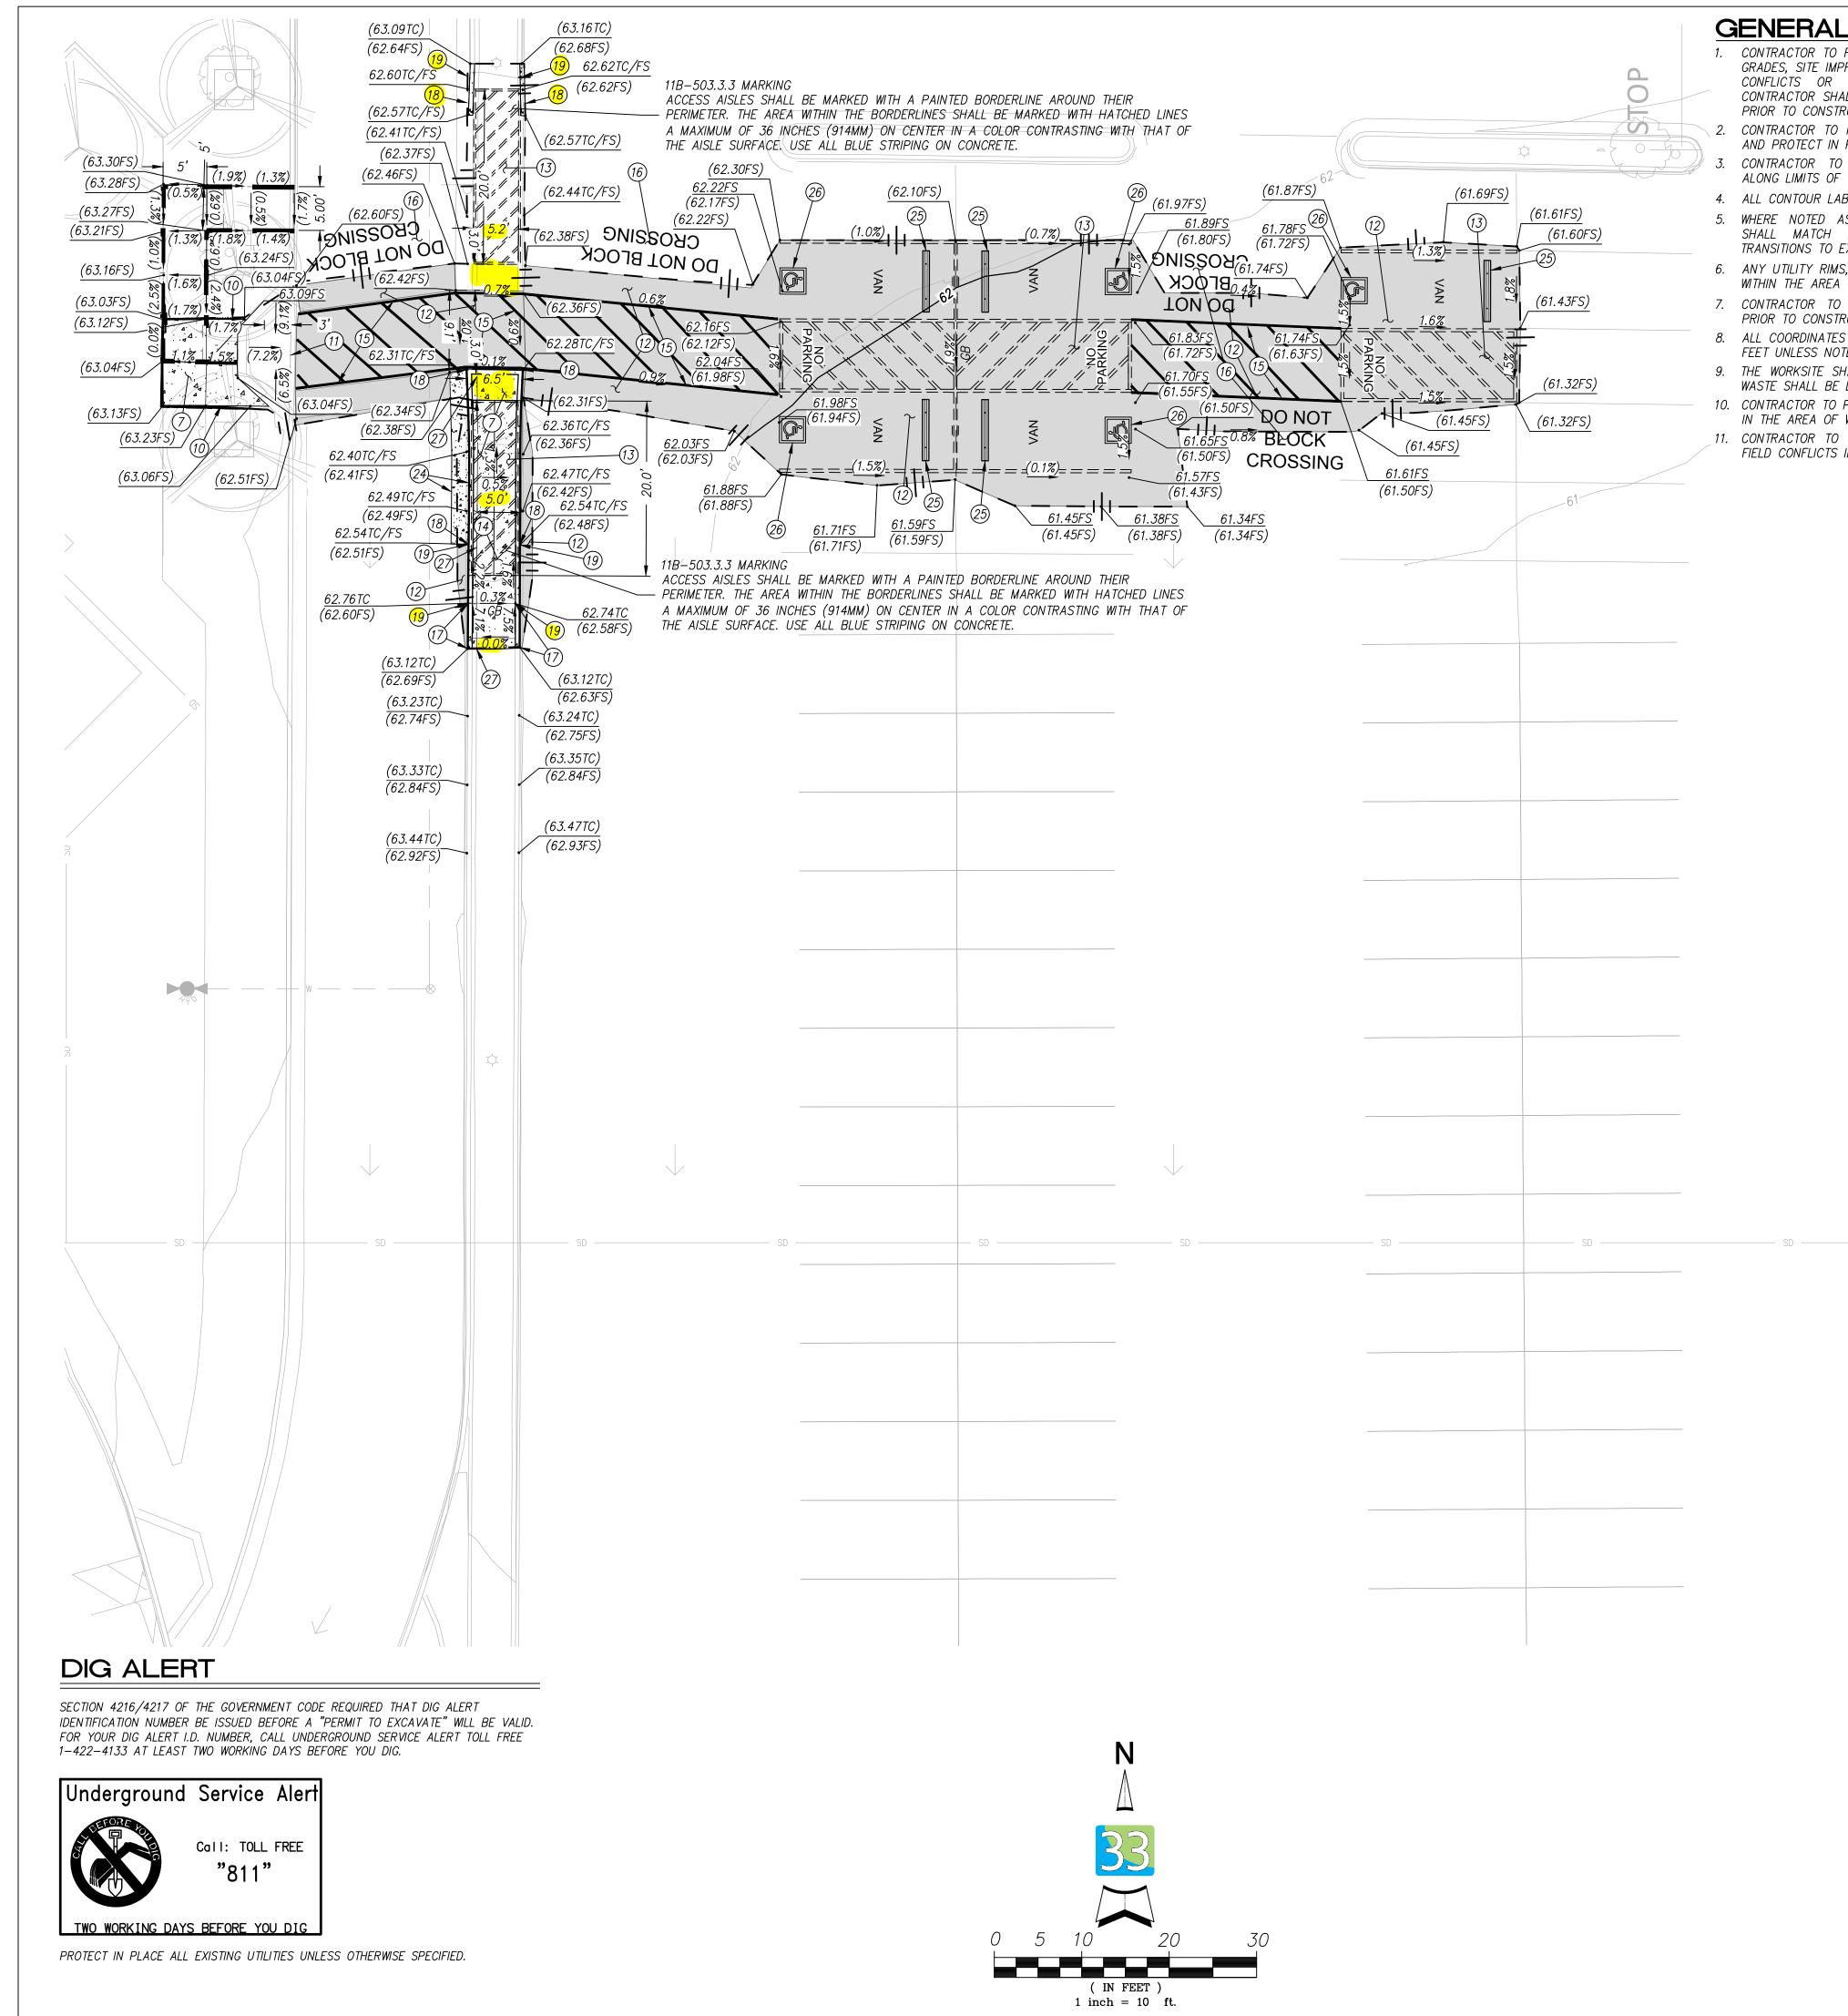

GENERAL NOTES

- 1. CONTRACTOR TO FIELD VERIFY EXACT LOCATION AND ELEVATION OF EXISTING GRADES, SITE IMPROVEMENTS AND UTILITIES PRIOR TO CONSTRUCTION. IF ANY CONFLICTS OR DEVIATIONS FROM THIS PLAN ARE IDENTIFIED, THE CONTRACTOR SHALL NOTIFY AND COORDINATE WITH THE ENGINEER OF WORK PRIOR TO CONSTRUCTION.
- 2. CONTRACTOR TO PERFORM UTILITY LOCATING AND POTHOLING AS REQUIRED, AND PROTECT IN PLACE ALL EXISTING UTILITIES.
- CONTRACTOR TO MATCH EXISTING PAVEMENT GRADES AND ELEVATIONS ALONG LIMITS OF WORK UNLESS OTHERWISE NOTED.
- 4. ALL CONTOUR LABELS AND ELEVATION CALLOUTS ARE IN UNITS "FEET" 5. WHERE NOTED AS "MATCH", NEW PAVEMENTS, SIDEWALKS, AND GRADES SHALL MATCH EXISTING GRADE ELEVATIONS AND PROVIDE SMOOTH TRANSITIONS TO EXISTING.
- 6. ANY UTILITY RIMS, TOPS OF GRATES, AND/OR LIDS (EXISTING OR PROPOSED) WITHIN THE AREA OF WORK SHALL BE ADJUSTED TO GRADE IN THE FIELD.
- 7. CONTRACTOR TO VERIFY ELEVATIONS AT TIE-IN AND/OR MATCH POINTS PRIOR TO CONSTRUCTION. 8. ALL COORDINATES AND DIMENSIONS ARE TO EDGE OF PAVEMENT AND ARE IN
- FEET UNLESS NOTED OTHERWISE. 9. THE WORKSITE SHALL BE KEPT CLEAN OF DEBRIS AND WASTE. DEBRIS AND WASTE SHALL BE DISPOSED OF AT APPROVED SITES.
- 10. CONTRACTOR TO PROTECT IN PLACE ANY AND ALL ROOF DRAIN DOWNSPOUTS IN THE AREA OF WORK.
- 11. CONTRACTOR TO PROVIDE ENGINEER OF WORK SUFFICIENT NOTICE OF ANY FIELD CONFLICTS IN ORDER TO PREPARE FOR DESIGN RESOLUTION.

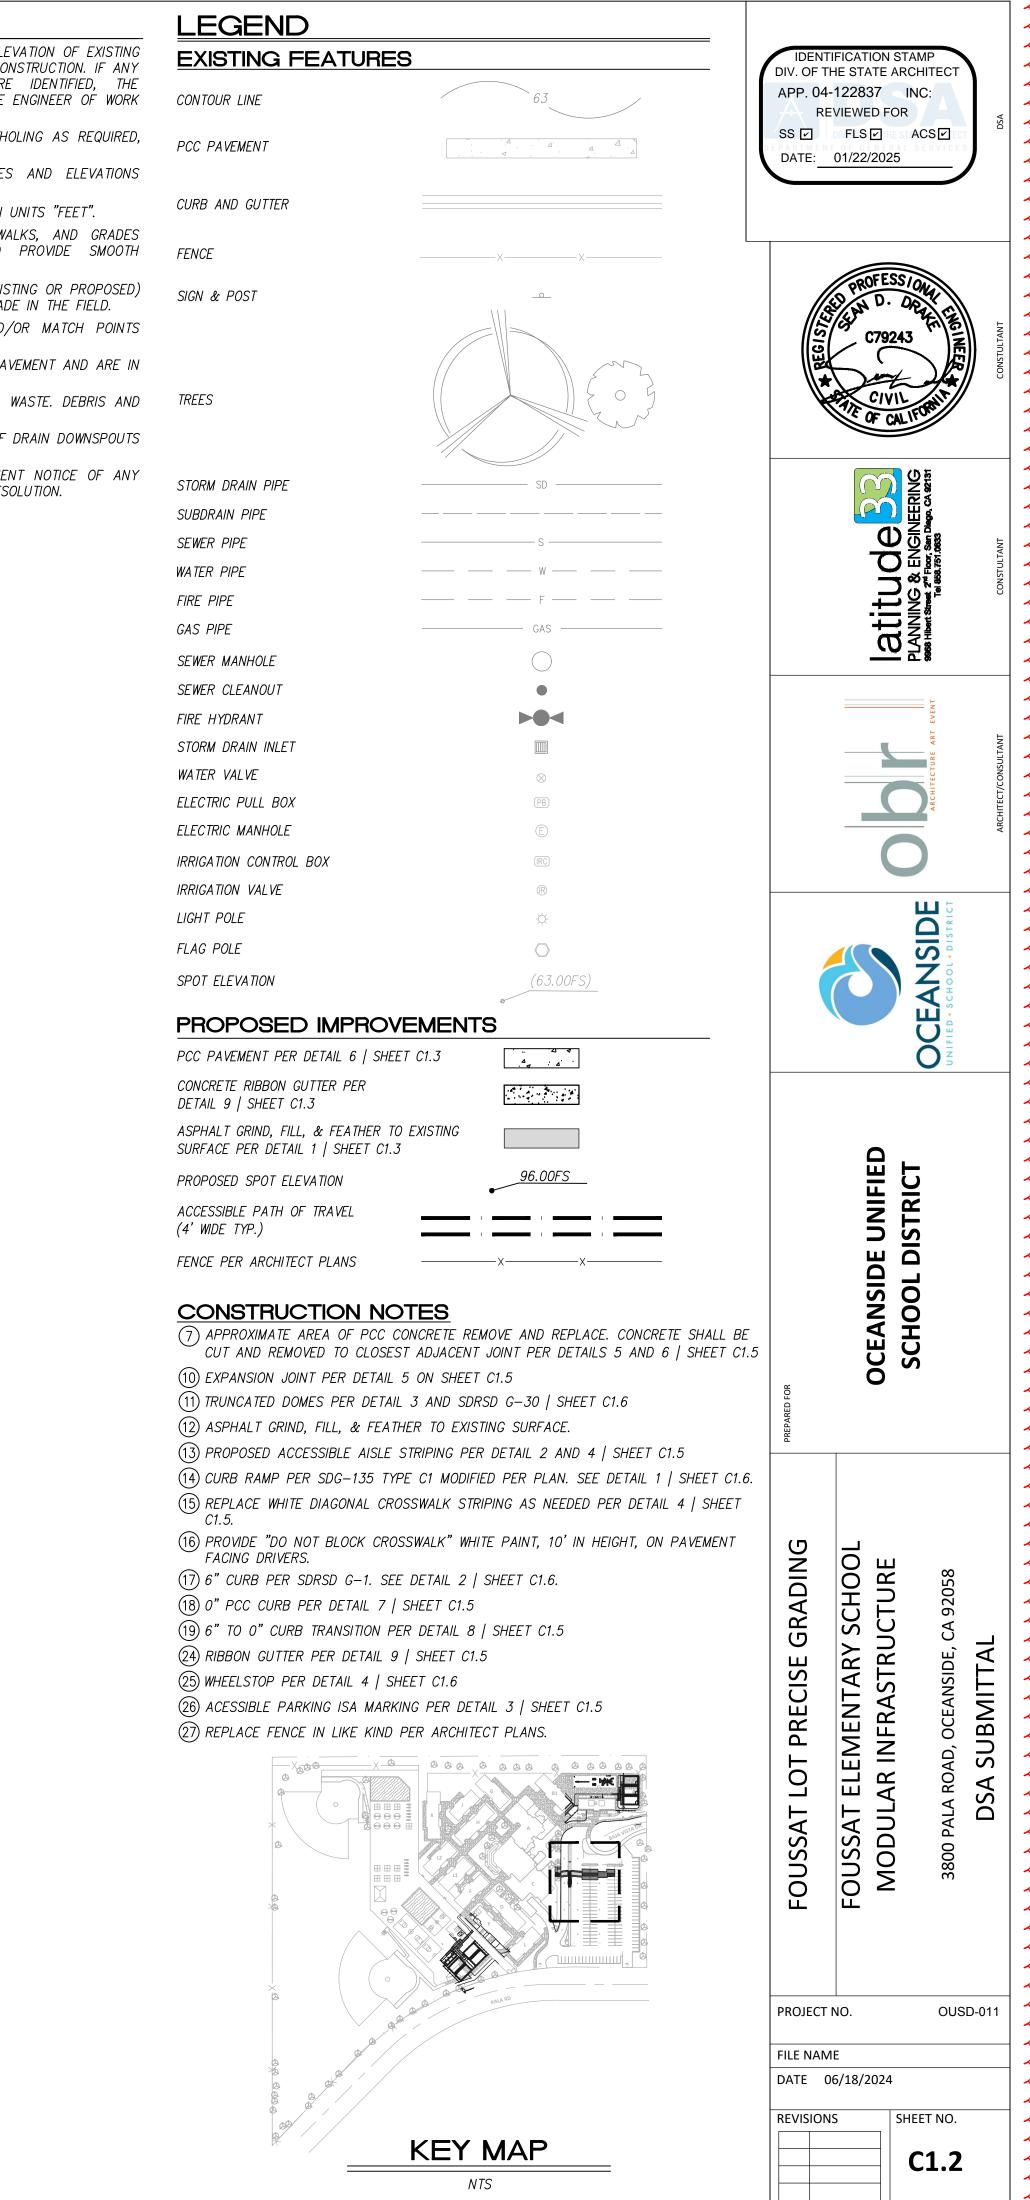











Option 1 - Just Mirror option

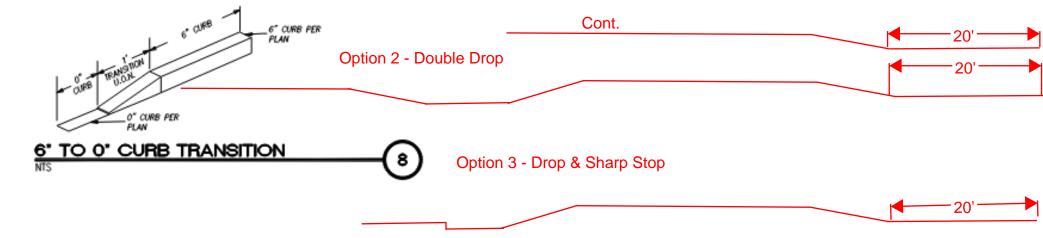








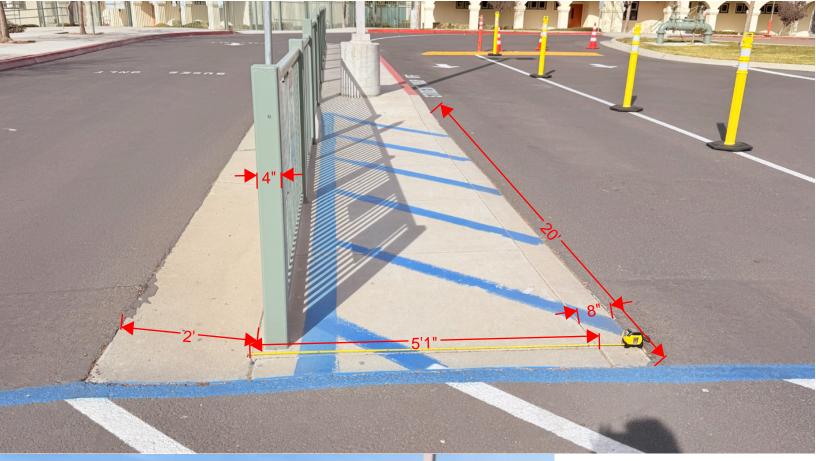



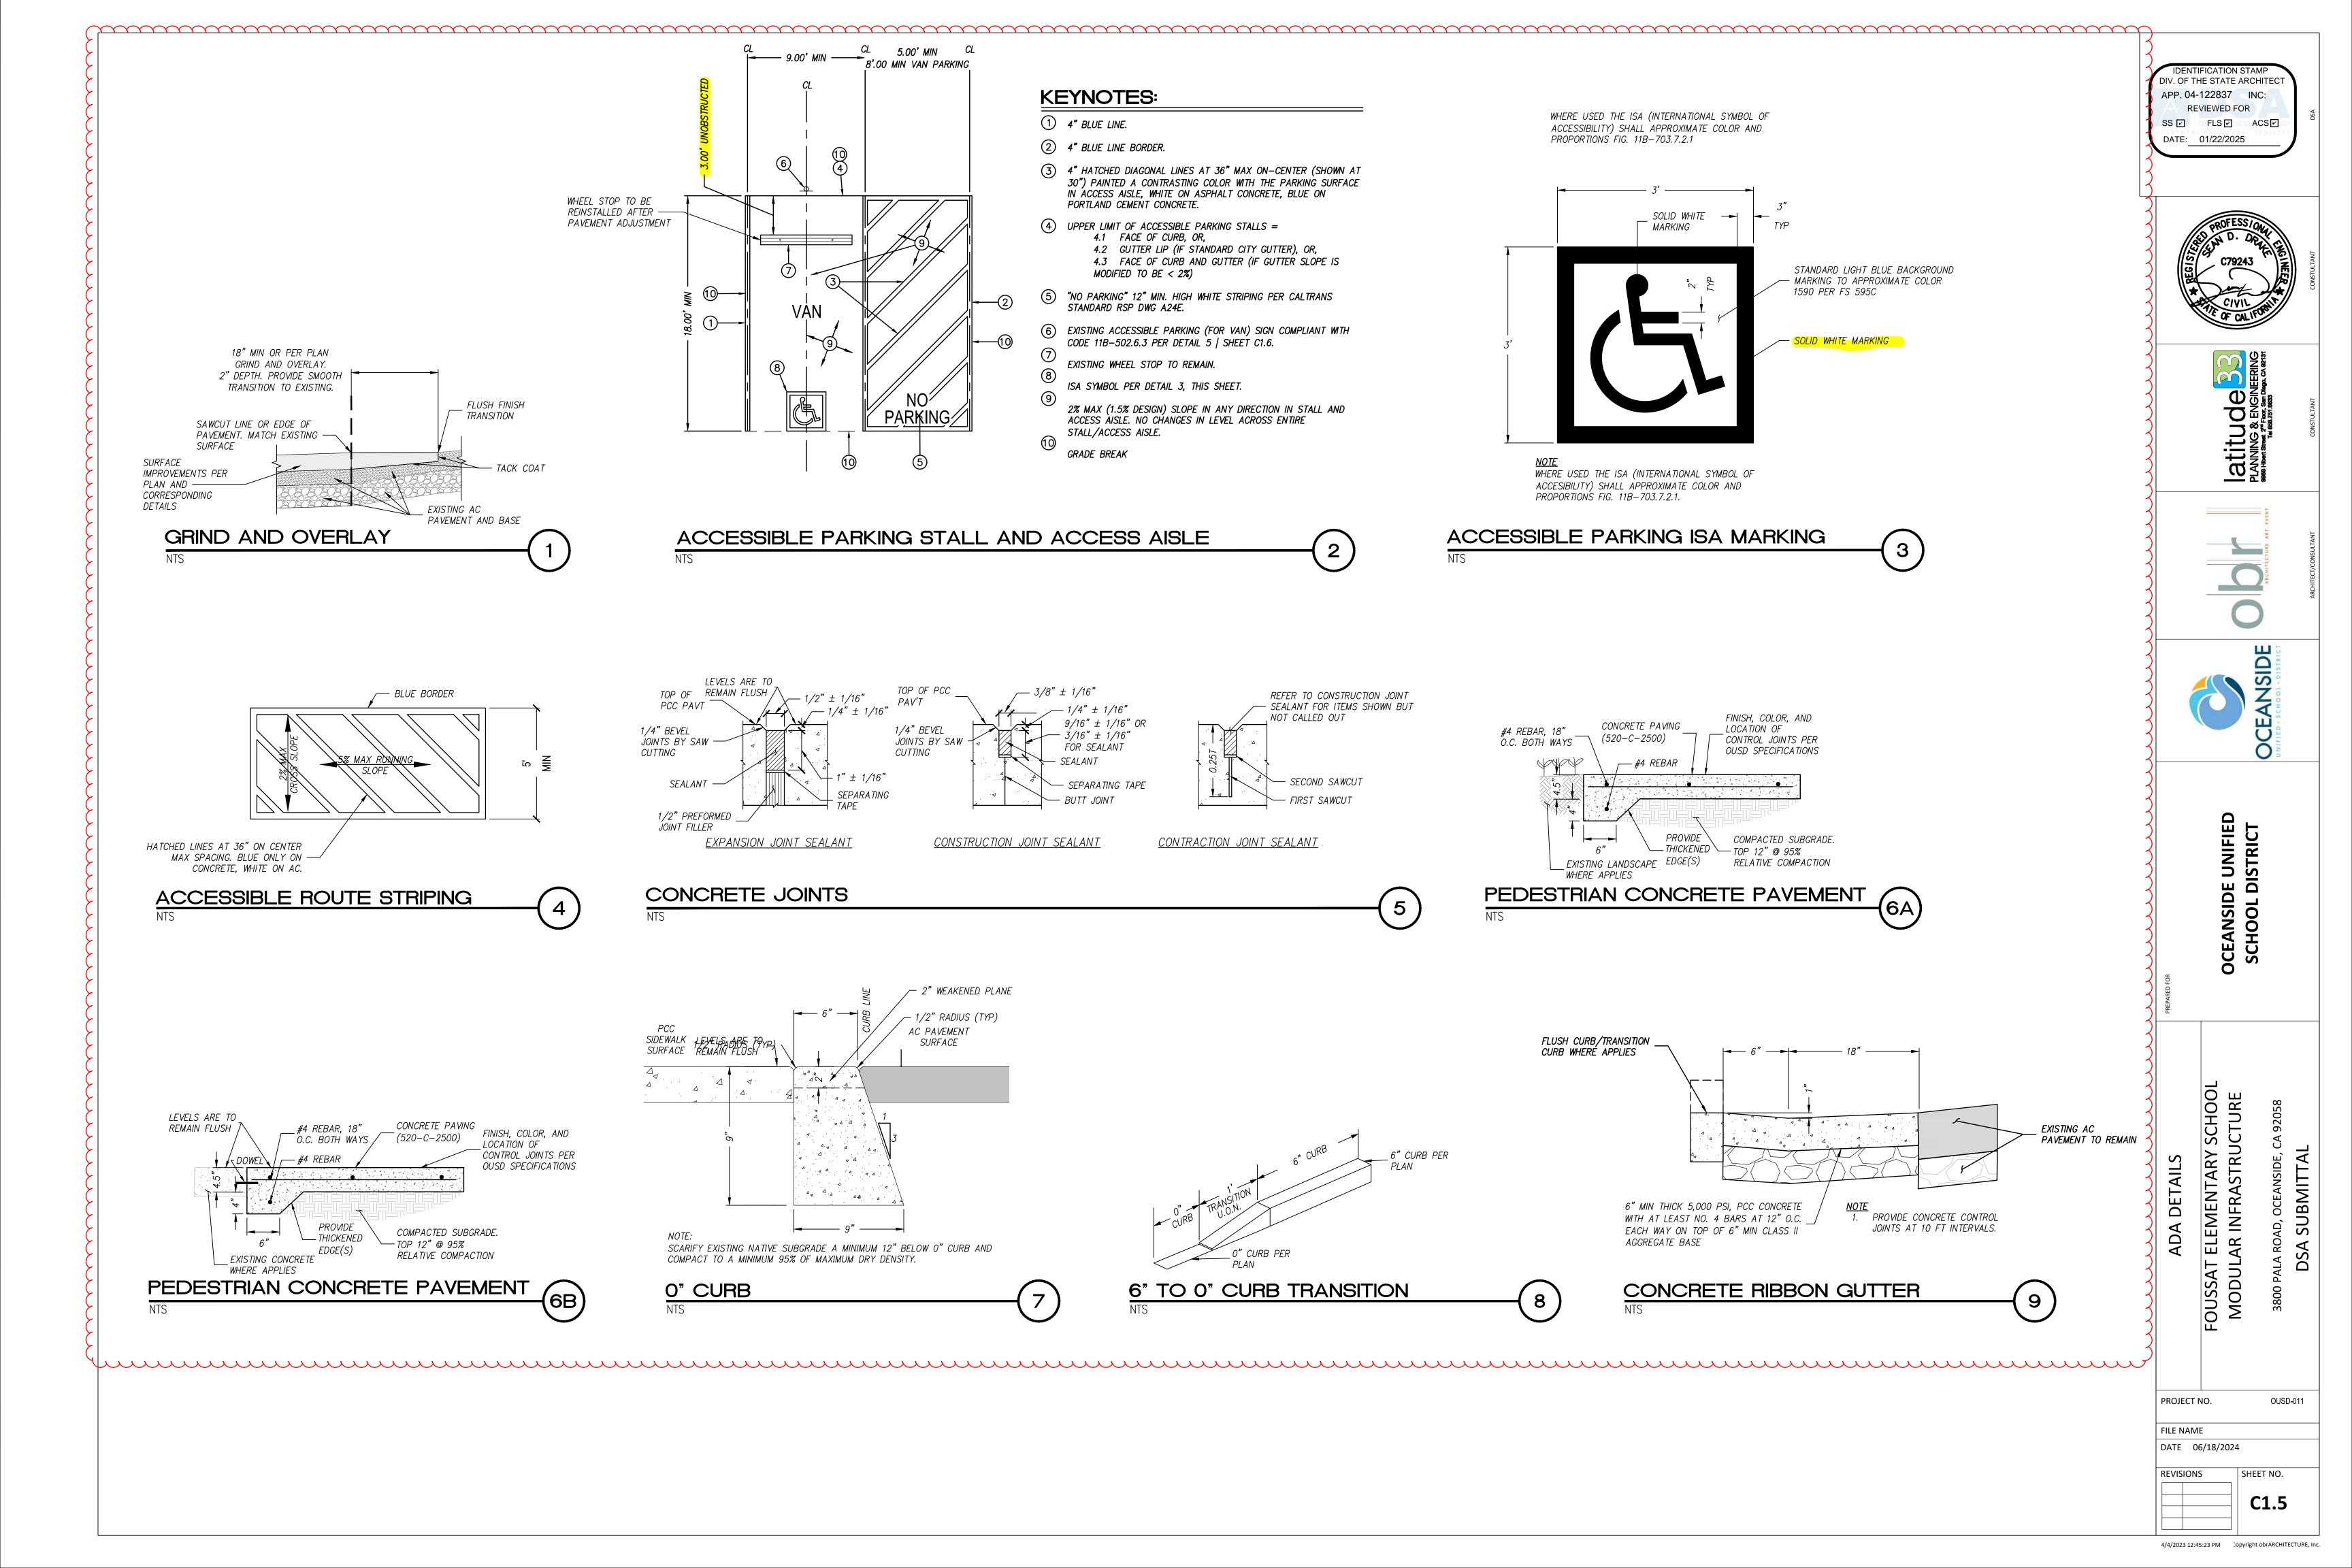














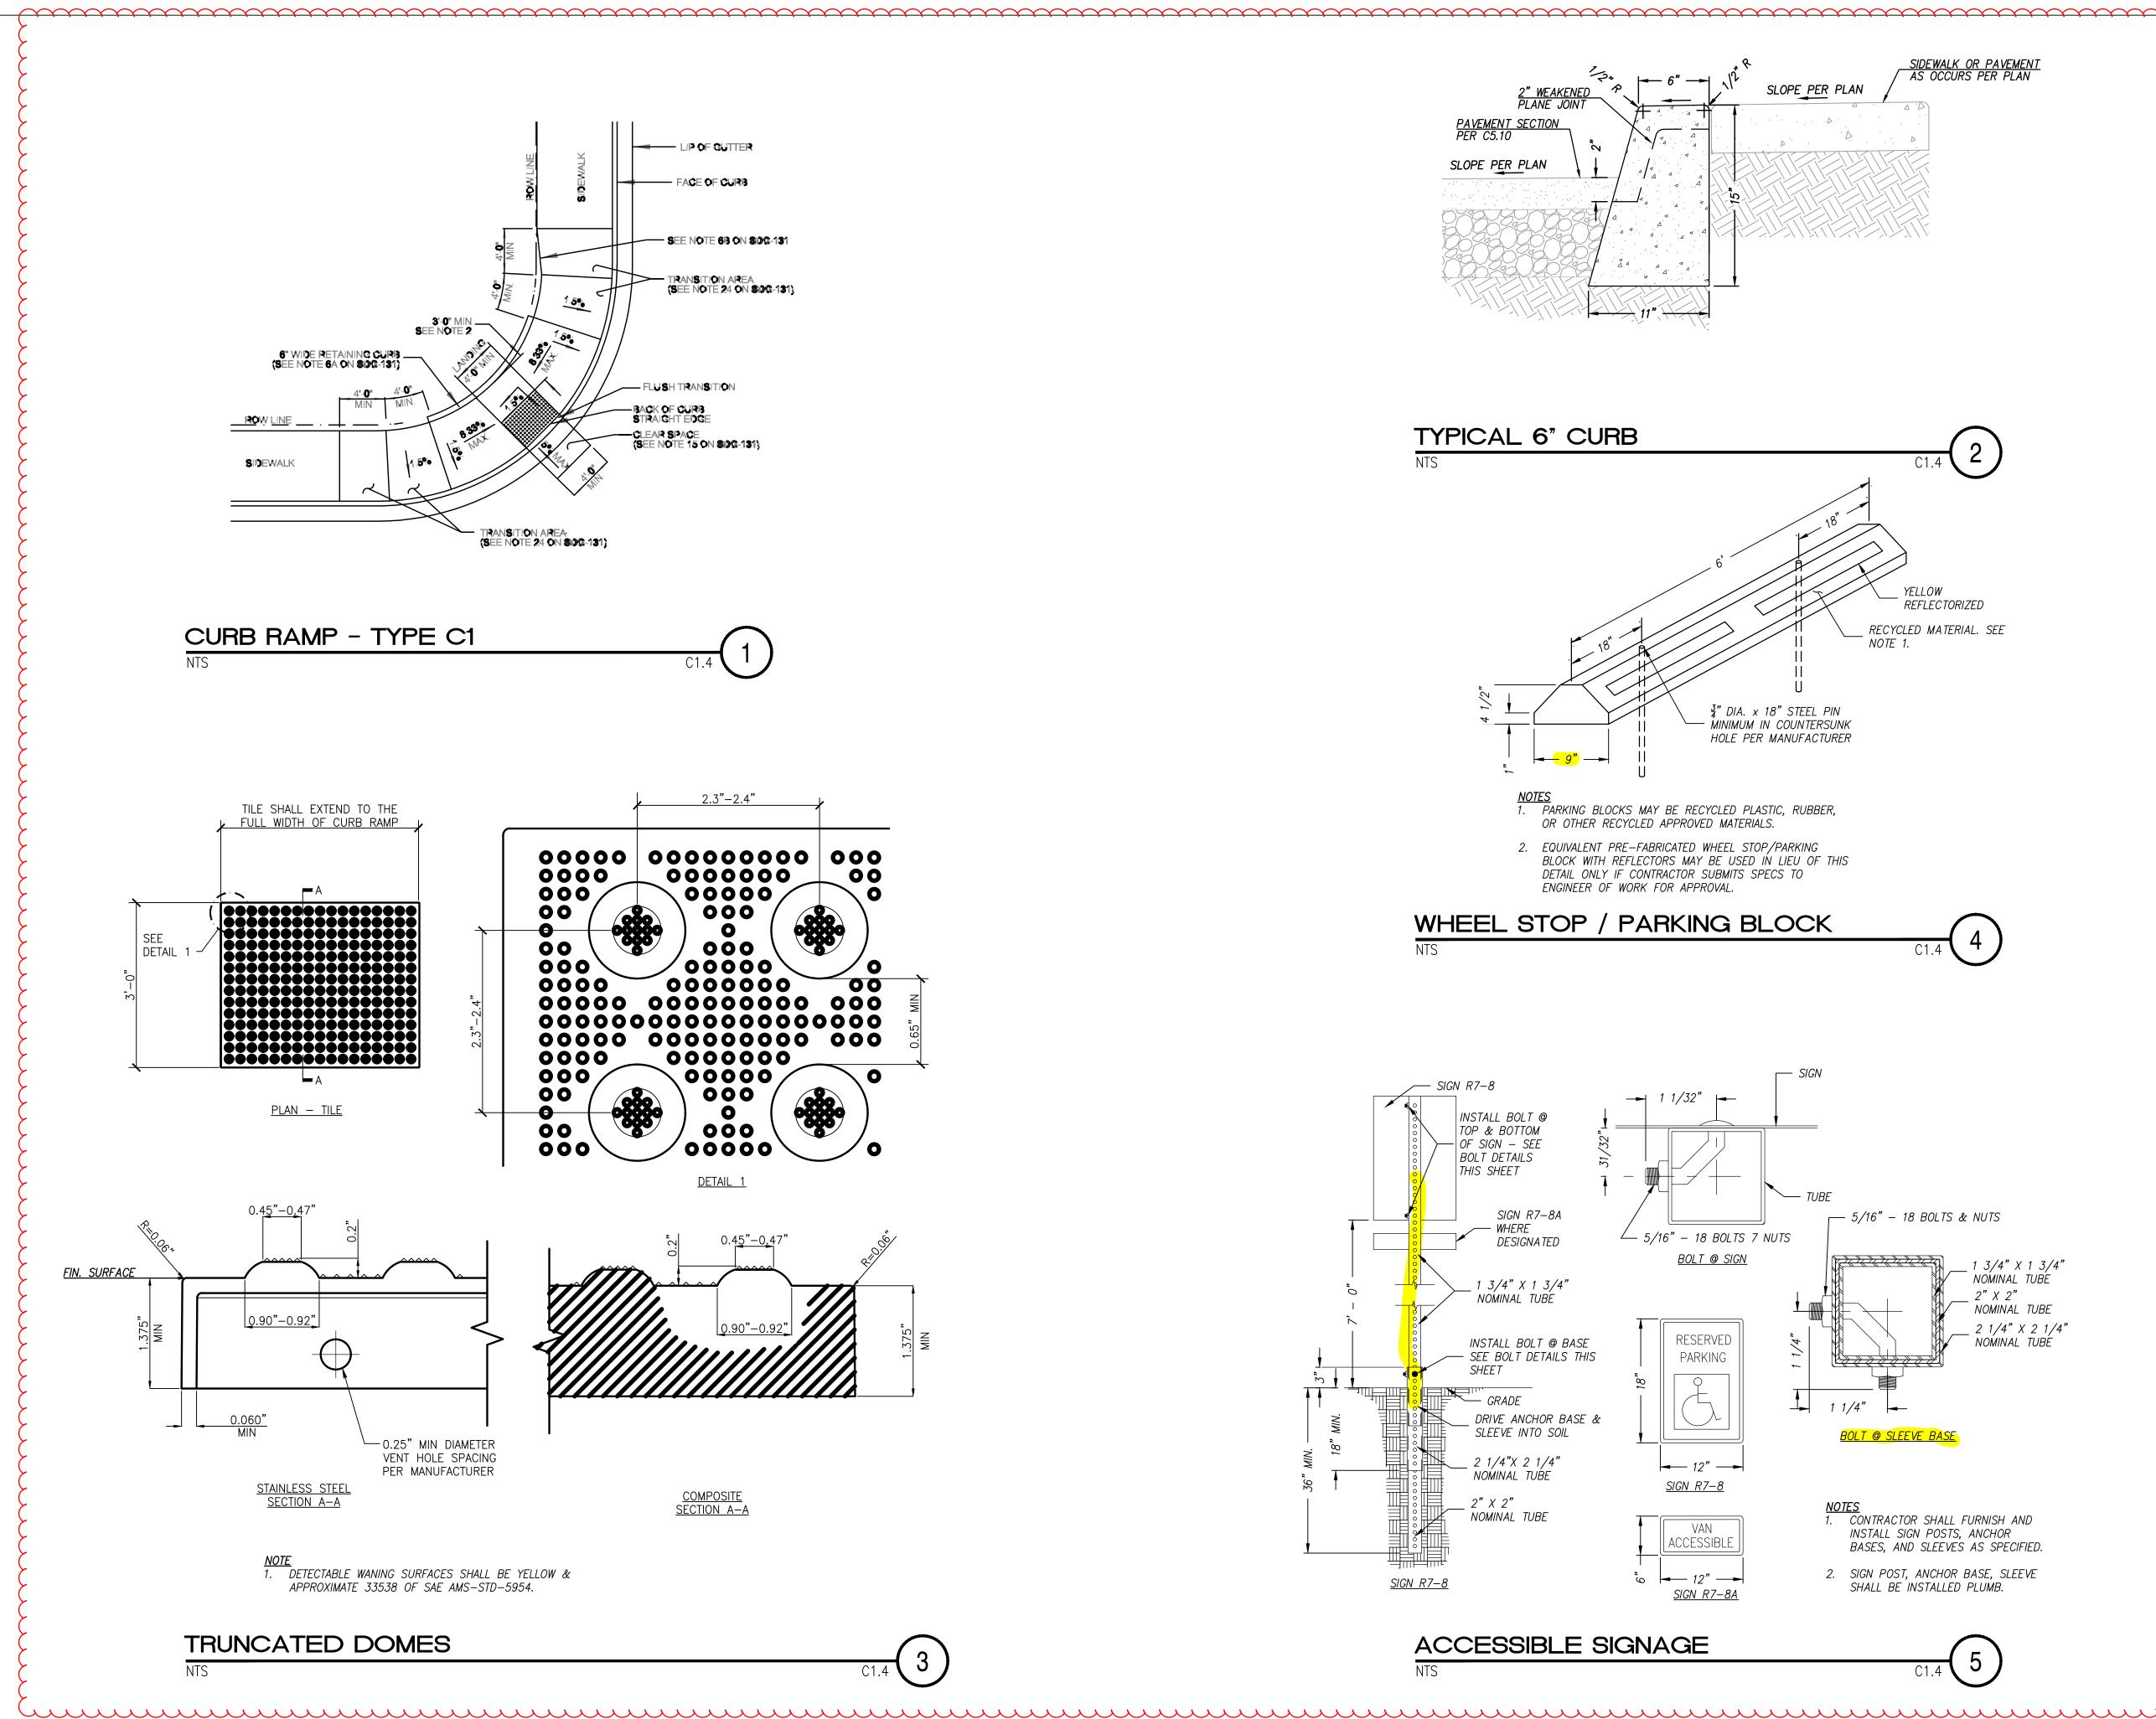


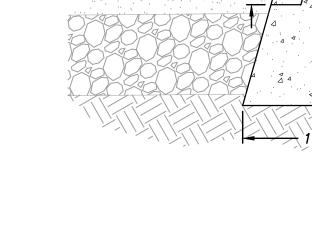

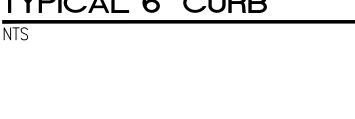

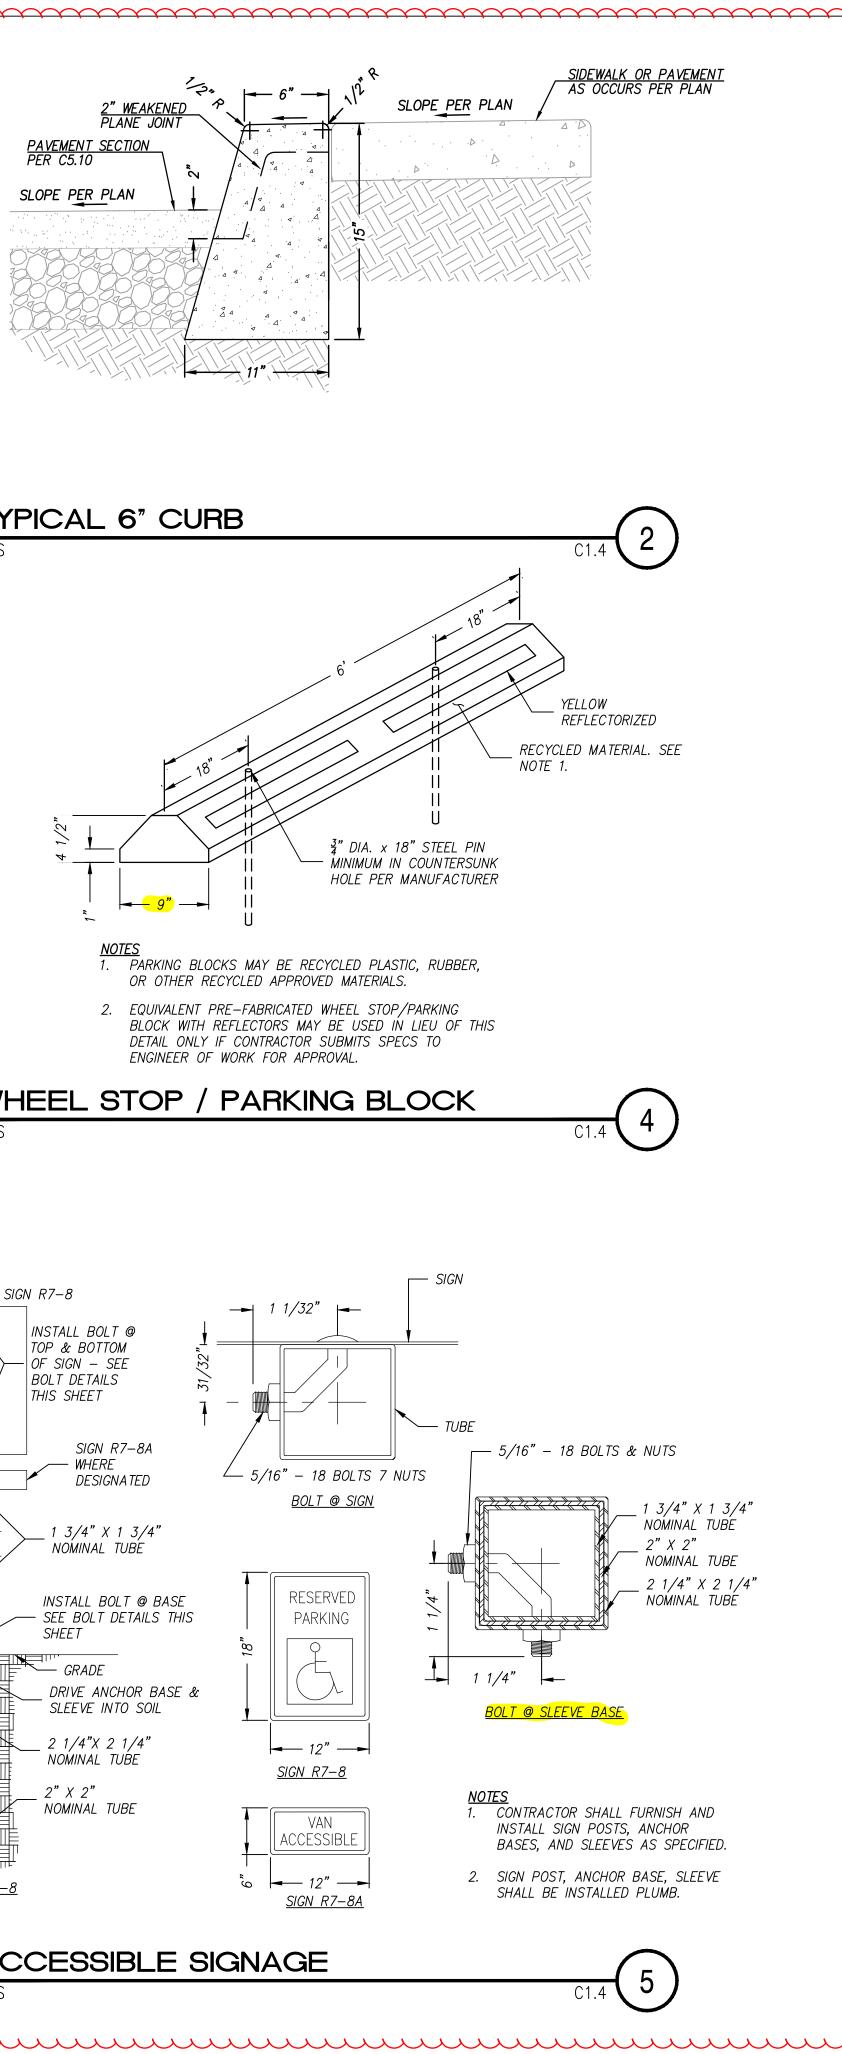

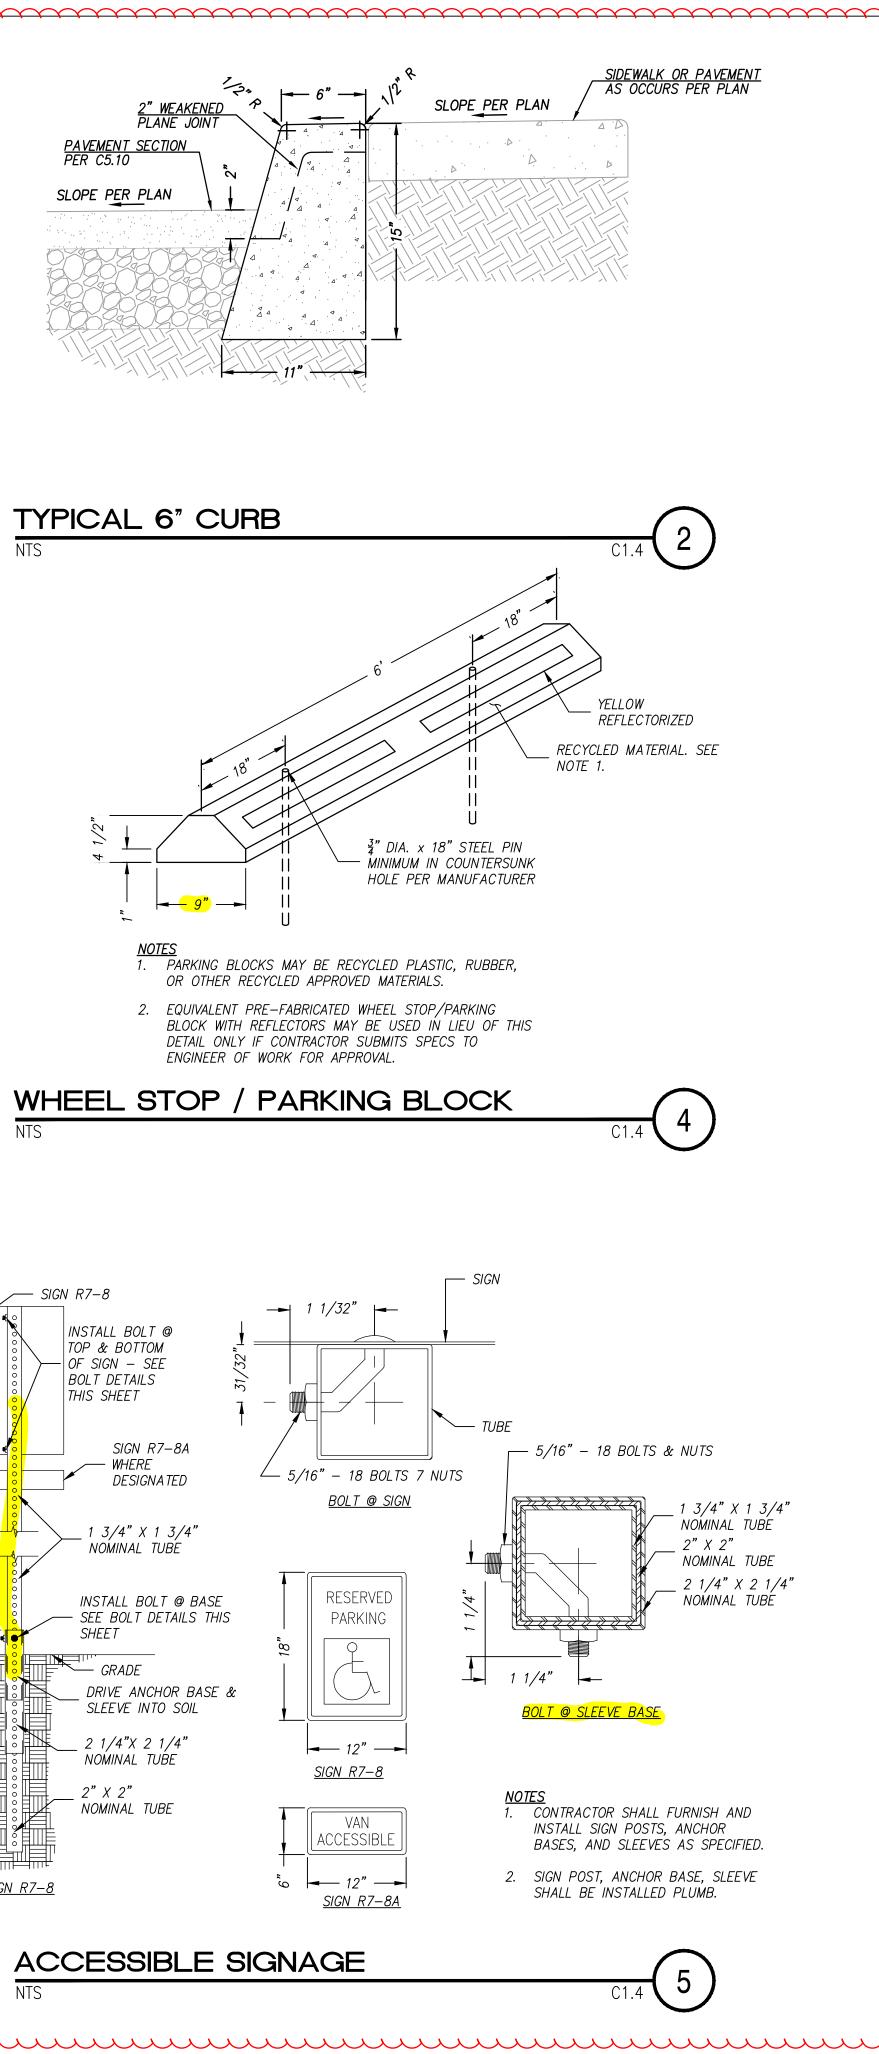

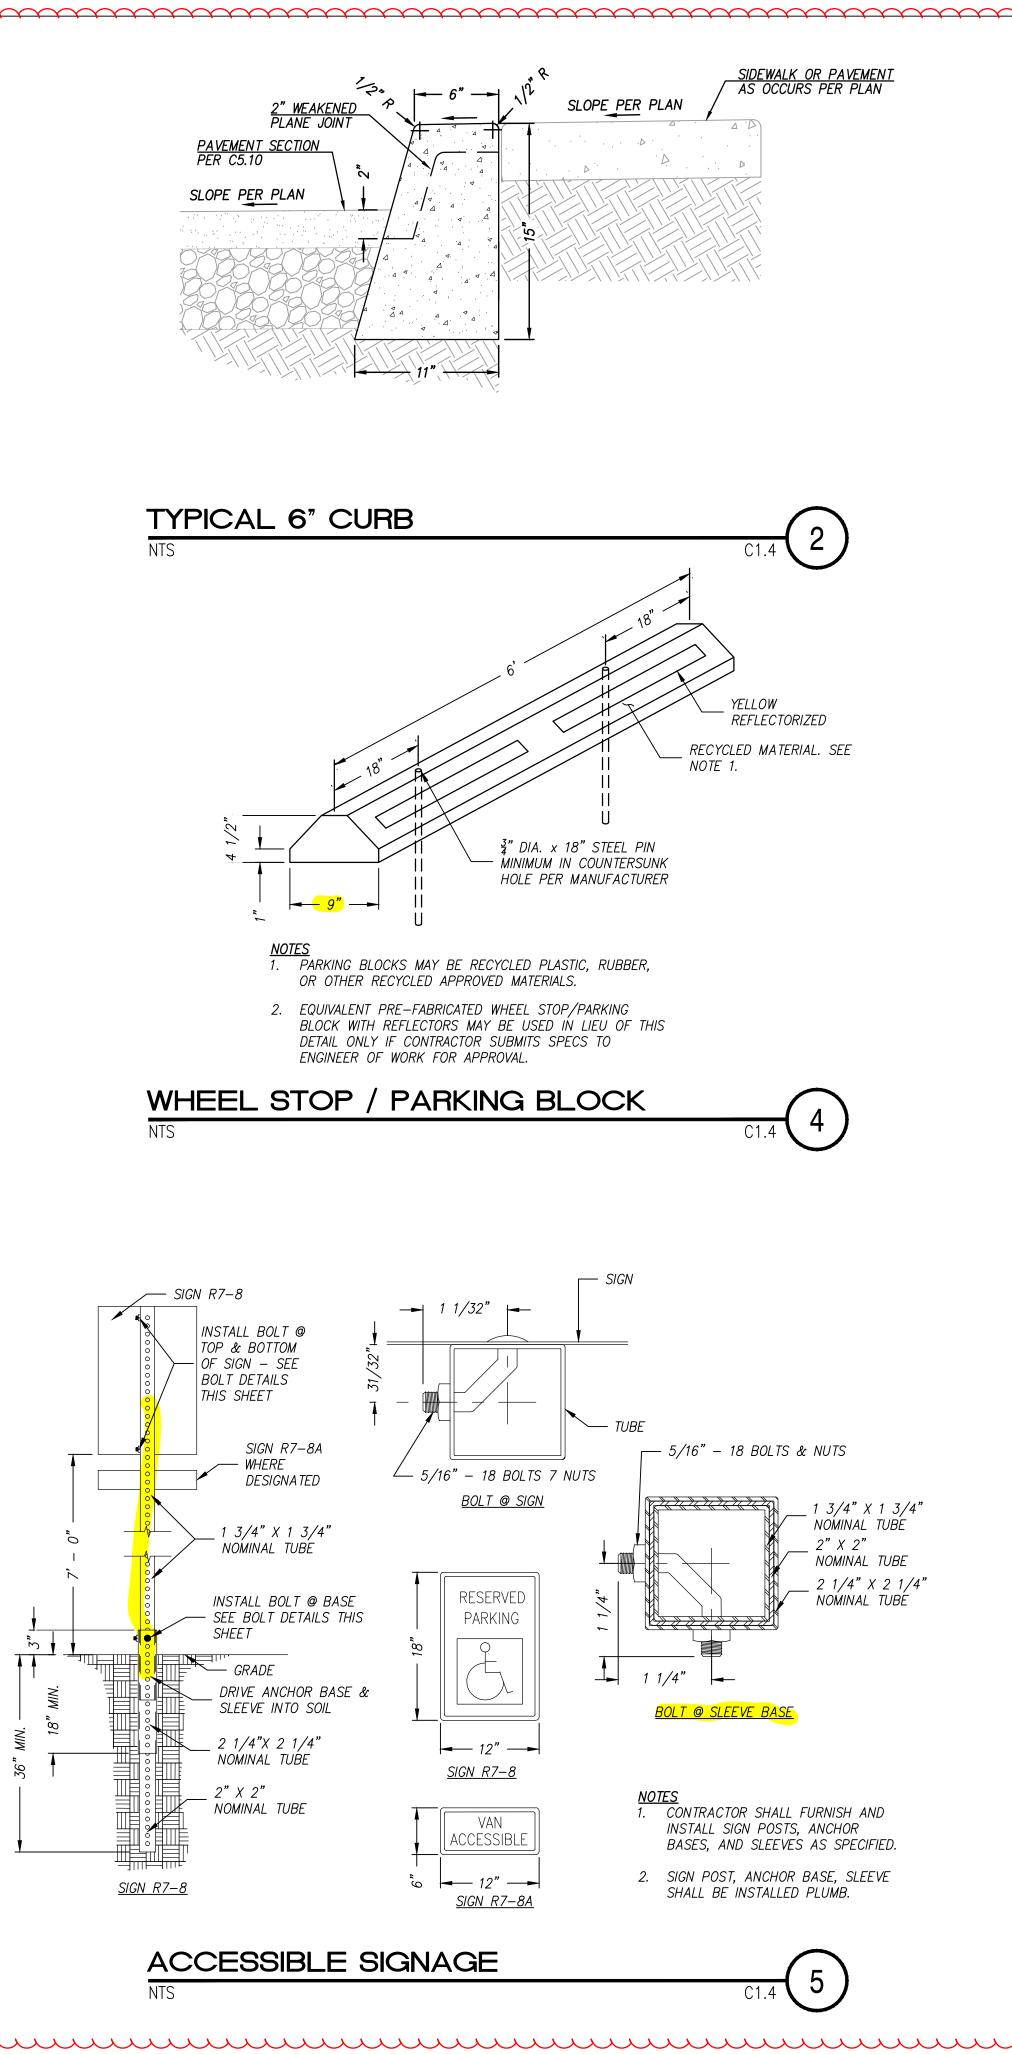














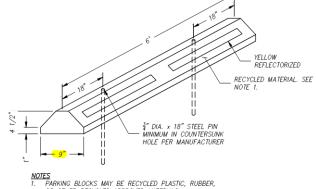

4

C1.4

EQUIVALENT PRE-FABRICATED WHEEL STOP/PARKING BLOCK WITH REFLECTORS MAY BE USED IN LIEU OF THIS DETAIL ONLY IF CONTRACTOR SUBMITS SPECS TO ENGINEER OF WORK FOR APPROVAL.



Attachment C



1: NEWCO	WILLIAM LEFEVRE	760-508-4369	ESTIMATING NEWCOGC
2 HISCE Builders	Steven Bengson	760-802.4038 est	moting & hace builders. com
3 Candace Williams MASSO	7	7607079119	5
+ Or a Builders Inc	Nasser 3	4-24-4349596	
5			
6			
7			
8			
9			
10			
11			
12			
13			
14			

2025-21-070B Libby & Foussat ADA Bid

OCEANSIDE UNIFIED SCHOOL DISTRICT PUBLIC WORKS CONTRACT FOR SERVICES

CONTRACT

This Contract ("Contract") is made by and between the **Oceanside Unified School District** ("District"), and between {**Contract Company**} ("Contractor").

District and Contractor hereby agree as follows:

1. <u>Description of Work</u>

The Contractor agrees to furnish all labor, materials, equipment, tools, supervision, appurtenances, and services, including transportation and utilities, required to perform and satisfactorily complete the following services per:

BID # {Contract #} {Title}

Scope of Work: Provide materials and services, including installation, as outlined in the attached proposal as Exhibit A

CONTRACT {Contract #} DIR Project ID/PWC-100 _____ DIR Registration ______ CLSB _____

2. <u>Contract Documents</u>

The Contract Documents consist of the executed Contract and all Addenda, the completed Bid Forms, the required Bonds and the Insurance forms, the Notice to Bidders, the Instructions to Bidders, the Notice of Award, the Notice to Proceed, the General Conditions and any Special Conditions, and the Specifications.

3. <u>Compensation</u>

As full compensation for the Contractor's complete and satisfactory performance of the work and activities described in the Contract Documents, the District agrees to pay Contractor, and Contractor agrees to accept the not to exceed total amount of

Contractor according to the Contract Documents.

Site/Location	Amount
	\$
	\$
	\$
	\$
Total Base Bid (not to exceed)	\$

4. <u>Prevailing Wages</u>

This Project is a public works project subject to prevailing wage requirements and Contractor and its Subcontractors are required to pay all workers employed for the performance of this Contract no less than the applicable prevailing wage rate for each such worker. Contractor acknowledges that the project is subject to compliance monitoring and enforcement by the California Department of Industrial Relations in accordance with Labor Code § 1770 et seq.

5. <u>Time for Completion</u>

The starting date of the Contract shall be the day listed by the District in the Notice to Proceed, estimated to be approximately {Contract Time} and the Contractor shall fully complete all the work before {Expiration Date} Time is of the essence in the performance of this Contract.

6. <u>Liquidated Damages</u>

Liquidated damages for the Contractor's failure to complete the Contract within the time fixed for completion are established in the amount of ______ dollars (\$ {Liquidated Damages}) per calendar day.

7. <u>Audit.</u>

The District and Contractor are subject to the examination and audit of the California State Auditor for a period of three (3) years after the final payment under this Contract, in compliance with Government Code §8546.7.

8. Mark-Up On Direct Costs of Changes.

In the event of Changes to the Work, pursuant to Article 9 of the General Conditions, the markup for all overhead, including but not limited to home-office overhead, safety, mailing or clean-up, field office overhead, all other general conditions costs, bond premium, and profit ("Change Order Mark-Up") for Changes completed by the Contractor shall be Fifteen **percent** (15%) of the direct actual costs for performance of the Change as determined in accordance with the provisions of Article 9 of the Construction General Conditions. For the portion of a Change completed by a Subcontractor, the Subcontractor Change Order Mark-Up shall be ten **percent** (10%) of the Subcontractor's direct actual costs for the Contractor may mark-up of five **percent** (5%) to the Subcontractor's direct actual costs for the Contractor's management, supervision and coordination of the Subcontractor's completion of such Change.

IN WITNESS WHEREOF, the parties agree to the terms of this Contract on the day and year written below.

CONTRACTOR	OCEANSIDE UNIFIED SCHOOL DISTRICT Andrea Norman, Ed.D.
Contractor Name	Name
Contractor Signature	Signature
	Associate Superintendent of Business Services
Title	Title
Date	Date
Corporation or Partnership (if corporation, seal below)	